


**STANLEY FURROW #1**  
 3960 FSL3960 FWL SENW 5 5N 61W 6th PM  
 Lat 40.432086 Long -104.235895 (from footages)  
 Weld County, Colorado  
 API #05-123-05193

Spud date 12/4/1952

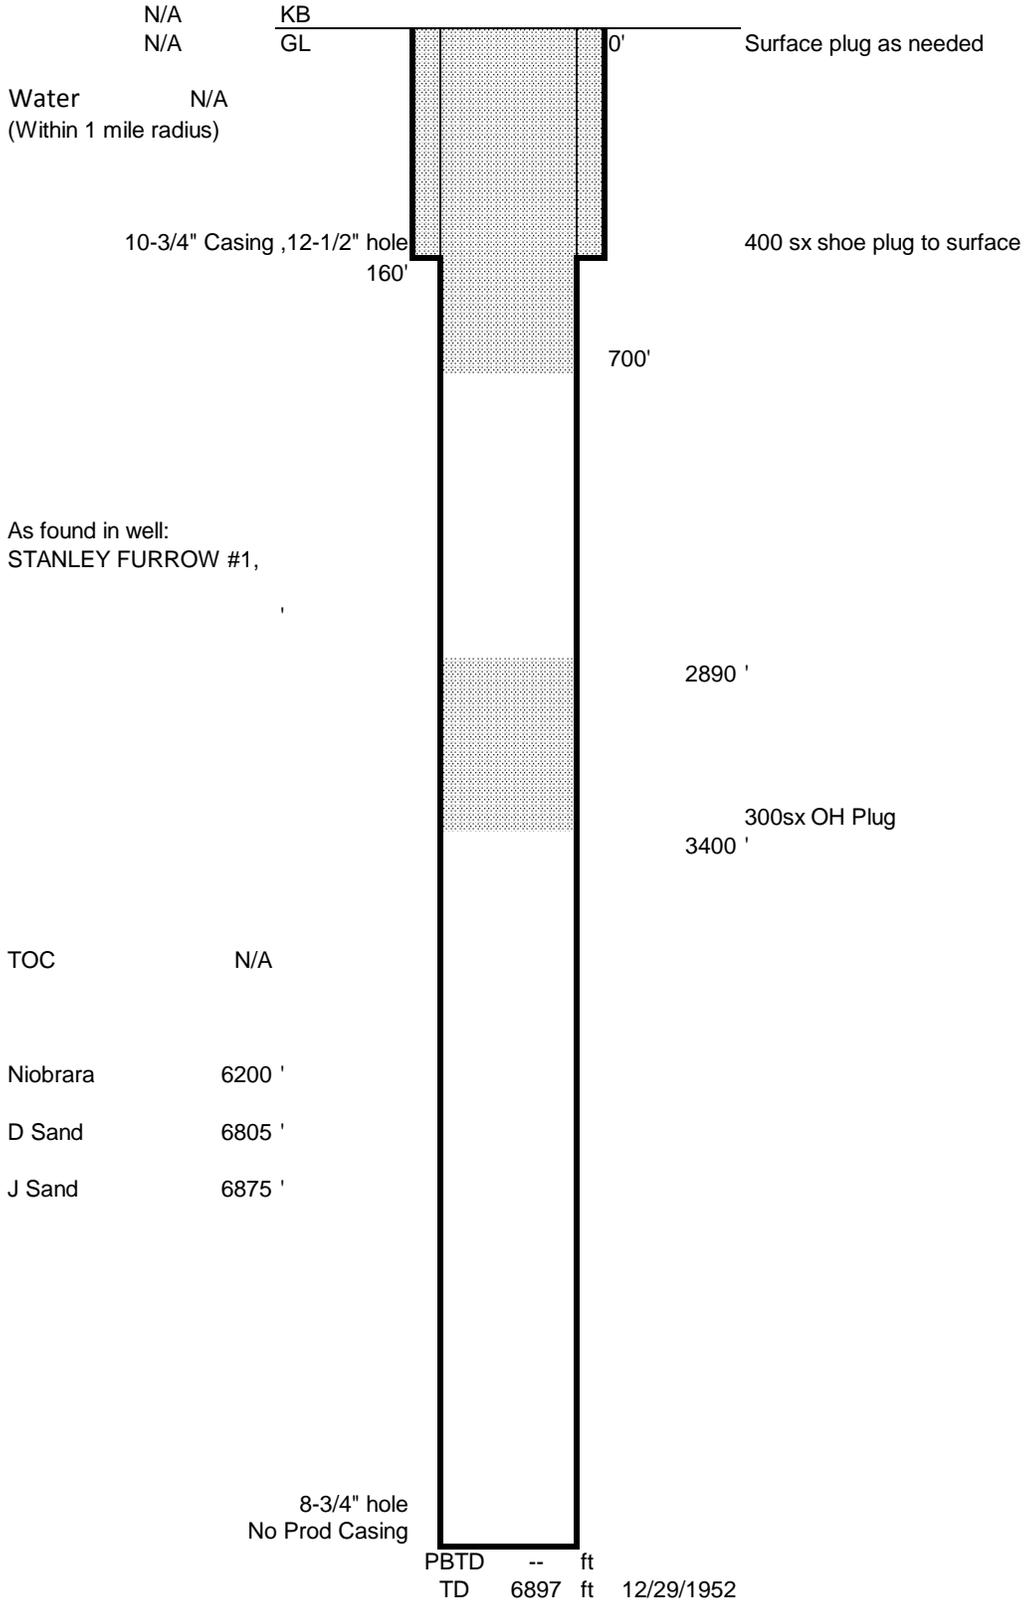

Updated 5/30/2014 jad