




Lat40°, Inc. 1635 Foxtrail Drive, Suite 325 Loveland, CO 970-776-3321

# PLUGGED & ABANDONED WELL EXHIBIT

THIS MAP DOES NOT REPRESENT A BOUNDARY SURVEY

SECTION: 5  
TOWNSHIP: 5N  
RANGE: 61W

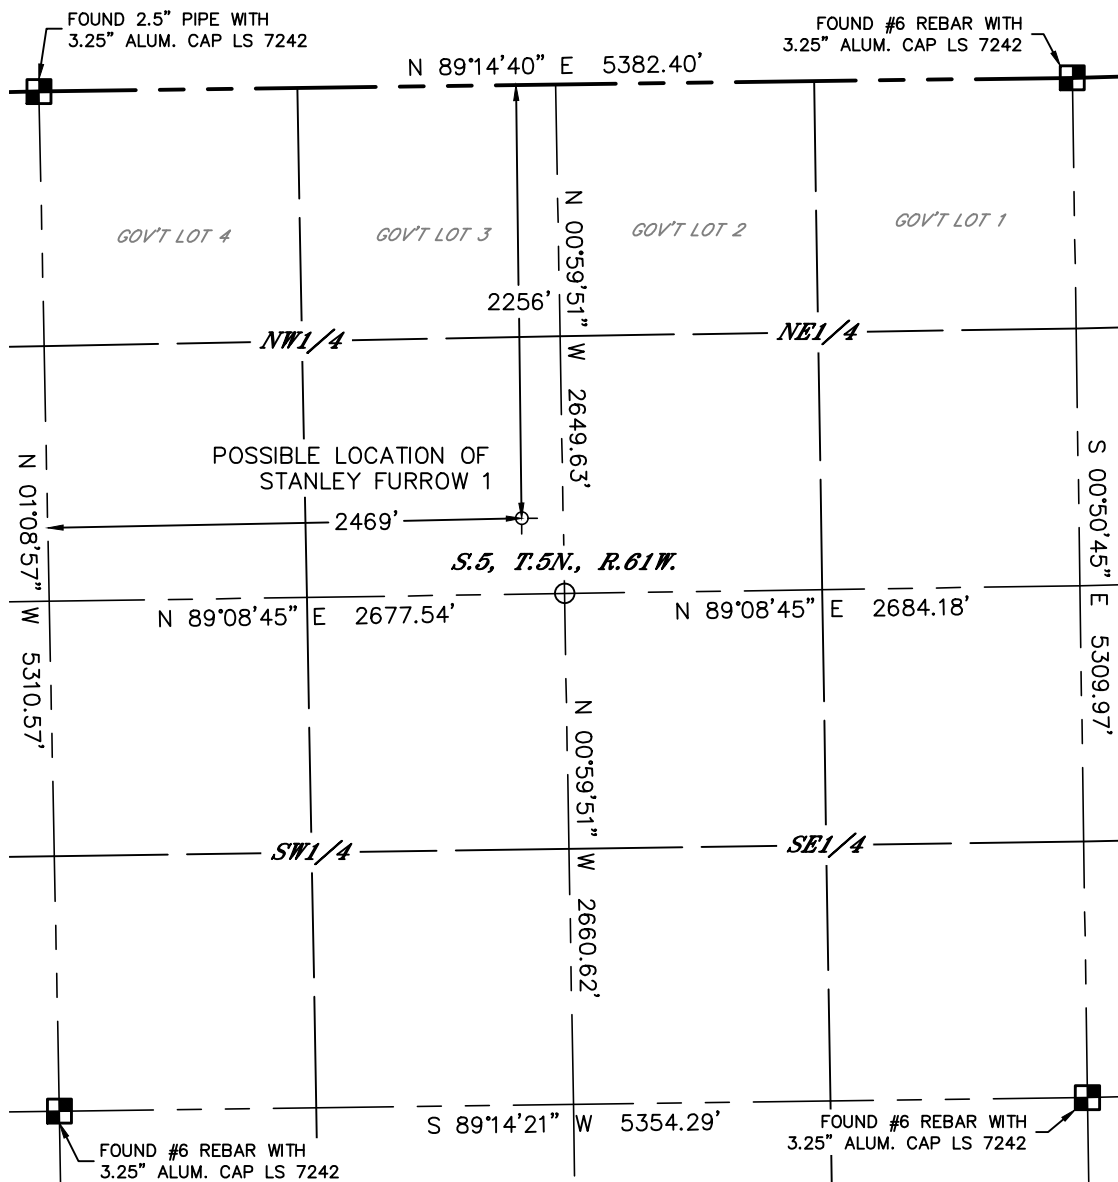

## SURFACE LOCATION

LAT: 40.43126°N  
LONG: 104.23410°W  
PDOP: 2.3  
ELEV: 4631'  
1/4,1/4: SE1/4NW1/4

## SURFACE DESCRIPTION

FOUND 2.5" YELLOW PIPE, 3.5' TALL, SET INSIDE OF A  
12" DIA. PIPE FILLED WITH GROUT. SET PINK LATH.

## LEGEND

- = ALIQUOT MONUMENT AS DESCRIBED
- = CALCULATED POSITION

DATE: 2/28/2014  
PROJECT#: 2013173





Lat40°, Inc. 1635 Foxtrail Drive, Suite 325 Loveland, CO 970-776-3321

## D&A WELL LOCATION PICTURES

STANLEY FURROW 1

SECTION: 5  
TOWNSHIP: 5N  
RANGE: 61W

DATE: 1/22/2014




VIEW NORTH



VIEW WEST



VIEW EAST

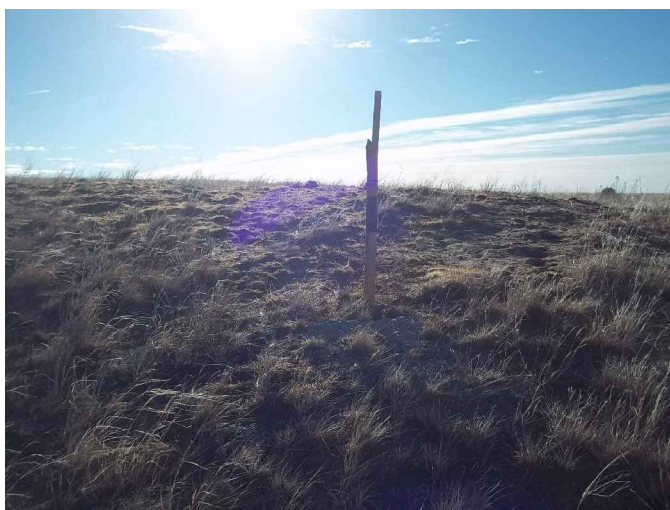

VIEW SOUTH

DATE: 2/28/2014  
PROJECT#: 2013173