

**KERR-MCGEE OIL AND GAS ONSHORE LP**

**UPRR 42 PAN AM AQ 1**

**NE SW 17 2N 66W -- --**

**WELD,COLORADO**

**05/13/2014**

**AREA: E3**

**ROUTE: E32 Spud: 03/23/1978**

**WINS No.: 73675**

**AFE/WO#: 2095763**

**API#: 0512309425**

**GL: 4869**

**KB: 4879**

**MTD: 7980**


**TVD: 7980**

**LOG MD: 7979**

**PBMD: 7937**

**PBTVD: 7937**

**Directions: HWY 85 & RD 20, E 2/10MILE, N 2/10 INTO ON WEST SIDE OF BRIDGE.**

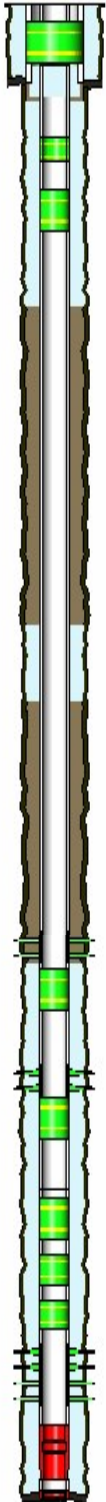

<u>HOLE SECTIONS</u>	<u>Size</u>	<u>Top</u>	<u>Btm</u>	<u>TD Date</u>
SURFACE	12.25	10	259	03/23/1978
PRODUCTION	7.88	259	7979	03/31/1978

<u>TUBULARS</u>	<u>Tool Type</u>	<u>Joints</u>	<u>Size</u>	<u>Weight</u>	<u>Grade</u>	<u>Thread</u>	<u>Top D</u>	<u>Bottom D</u>
SURFACE CASING	Casing	6	8.63	24	K-55	STC	10	259
PRODUCTION CASING	Casing	3	4.50	11.60	K-55	STC	10	110
	Casing	15	4.50	10.50	K-55	STC	110	713
	Cement Stage Too	1	4.50				713	714
	Casing	161	4.50	10.50	K-55	STC	714	7620
	Casing	8	4.50	11.60	K-55	STC	7620	7937
	Casing Float Collar	1	4.50				7937	7938
	Casing	1	4.50	11.60	K-55	STC	7938	7978
	Casing Guide Shoe	1	4.50				7978	7979
BRIDGE PLUG	Cast Iron Bridge Plu	1	4.50				7756	7757
BRIDGE PLUG	Cast Iron Bridge Plu	1	4.50				7700	7701
BRIDGE PLUG	Cast Iron Bridge Plu	1	4.50				7735	7736
CAST IRON CEMENT RETAINER	Cement Retainer	1	4.50				6748	6749
CAST IRON CEMENT RETAINER	Cement Retainer	1	4.50				7213	7214
CAST IRON CEMENT RETAINER	Cement Retainer	1	4.50				943	944
BRIDGE PLUG	Cast Iron Bridge Plu		8.63				100	102

<u>CEMENT JOBS</u>	<u>Stage</u>	<u>Sacks</u>	<u>Cement Jobs</u>	<u>Top D</u>	<u>Btm D</u>	<u>cbl</u>
SURFACE CASING	STAGE 1	200	G	10	259	No
PRODUCTION CASING	STAGE 1	200	50/50 POZ-MIX	7154	7979	No
	STAGE 2	200	50/50 POZ-MIX	405	715	No
PRODUCTION CASING	SQUEEZE JOB	140	LEAD FRESH WATER	6700	7200	No
PRODUCTION CASING	SQUEEZE JOB	470	LEAD FRESH WATER	4170	4800	No
PRODUCTION CASING	ABANDONMENT PLUC	320	LEAD FRESH WATER	920	1370	No
SURFACE CASING	ABANDONMENT PLUC	20	LEAD FRESH WATER	130	202	No
SURFACE CASING	ABANDONMENT PLUC	60	LEAD FRESH WATER	150	384	No

<u>PERFORATIONS</u>	<u>Zone</u>	<u>Top</u>	<u>Btm</u>	<u>Date</u>	<u>Reason</u>	<u>Comments</u>
		4170	4800	04/04/2014	CEMENT SQUEEZE	
		6699	6700	04/03/2014	CEMENT SQUEEZE	

KERR-MCGEE OIL AND GAS ONSHORE LP

UPRR 42 PAN AM AQ 1

NE SW 17 2N 66W -- --

WELD,COLORADO

05/13/2014

AREA: E3

ROUTE: E32

Spud: 03/23/1978

WINS No.: 73675

AFE/WO#: 2095763

API#: 0512309425

GL: 4869

KB: 4879

MTD: 7980

TVD: 7980

LOG MD: 7979

PBMD: 7937

PBTVD: 7937

Directions:

HWY 85 & RD 20, E 2/10MILE, N 2/10 INTO ON WEST SIDE OF BRIDGE.

	7199	7200	04/03/2014	CEMENT SQUEEZE
J SAND	7838	7842	07/25/1978	PRODUCTION
J SAND	7848	7882	07/25/1978	PRODUCTION

Comments: