

Physical Address: 345 Comanche St.
Mail to: Box 384, Kiowa, CO 80117
Ph. 303-621-8672 - Fax 303-621-7749
www.highprairiesurvey.com


Job # 13171 Big Wampum #8

Inv # 3137

High Prairie Surveying of Kiowa, Colorado, in accordance with a request from Wiepking Fullerton, has determined the location of Big Wampum #8 to be 660 feet FSL, and 660 feet FEL, (90° off Section lines) of SECTION 23, Township 10s, Range 56w of the 6th Principal Meridian, Lincoln County, Colorado.

Date: Staked on 05/14/14 drawn on 05/15/14.

Re: Staked by Elijah Frane
Drawn: Drawn by Dustin Cotter

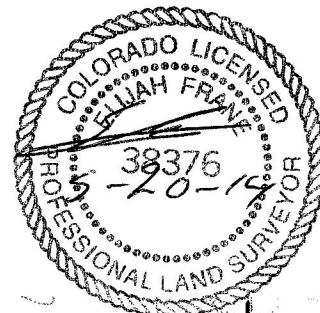

Access Road Map

