

## KERR-MCGEE OIL AND GAS ONSHORE LP

APOLLO 1

-- -- 19 1N 65W 990' FNL 990' FEL


WELD,COLORADO

05/29/2014

AREA: ROUTE: Spud: 02/01/1975 WINS No.: H7816 AFE/WO#: 2097853 API#: 0512308243

GL: 4985 KB: 4995 MTD: 7955 TVD: 7955 LOG MD: 7961 PBMD: 7927 PBTVD: 7927

Directions: CR 8 &amp; CR 39, S 2/10, W INTO

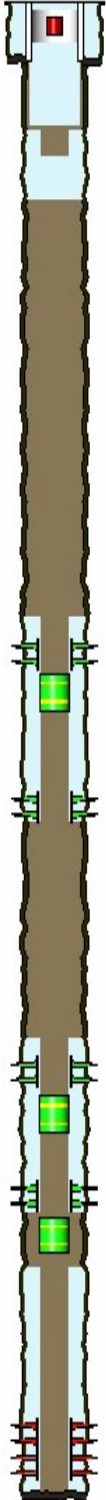

HOLE SECTIONS	Size	Top	Btm	TD Date
SURFACE	12.25	10	260	02/01/1975
PRODUCTION	7.88	260	7955	02/14/1975

TUBULARS	Tool Type	Joints	Size	Weight	Grade	Thread	Top D	Bottom D
SURFACE CASING	Casing		8.63	24.00			10	260
CIBP	CIBP With CMT Cap	1	4.50				7000	7002
CAST IRON CEMENT RETAINER	Cement Retainer		4.50				6620	6622
CAST IRON CEMENT RETAINER	Cement Retainer		4.50				4345	4347
BRIDGE PLUG	Wellbore Equipment	1					80	80

CEMENT JOBS	Stage	Sacks	Cement Jobs	Top D	Btm D	cbl
SURFACE CASING	PRIM CMT 1ST STAGE	225	REGULAR	10	260	No
PRODUCTION CASING	PRIM CMT 2ND STAGE	250	50/50 POZ-MIX	750	1115	No
	PRIM CMT 1ST STAGE	300	50/50 POZ-MIX	7075	7960	No
--None--	ABANDONMENT PLUC	10	REGULAR	14	46	No
PRODUCTION CASING	ABANDONMENT PLUC	190	LEAD FRESH WATER	6425	6961	No
PRODUCTION CASING	ABANDONMENT PLUC	20	LEAD FRESH WATER	925	1230	No
PRODUCTION CASING	ABANDONMENT PLUC	630	LEAD FRESH WATER	4150	4916	No
SURFACE CASING	ABANDONMENT PLUC	209	LEAD FRESH WATER	129	710	No
SURFACE CASING	SQUEEZE JOB	45	LEAD FRESH WATER	40	45	No

PERFORATIONS	Formation	Zone	Top	Btm	Date	Reason	Comments
			4310	4311	05/07/2014	CEMENT SQUEEZE	
			4915	4916	05/07/2014	CEMENT SQUEEZE	
			6560	6561	05/06/2014	CEMENT SQUEEZE	
			6960	6961	05/06/2014	CEMENT SQUEEZE	
J SAND			7861	7863	02/20/1975	PRODUCTION	PERFS BELOW ABN PLUGS
J SAND			7870	7876	02/20/1975	PRODUCTION	

Comments: