


**KERR-MCGEE OIL AND GAS ONSHORE LP**  
**NICK SEKICH UNIT B 1**  
**NW NE 19 3N 67W 1,250' FNL 1,650' FEL**  
**WELD,COLORADO**  
**06/02/2014**

AREA: N2      ROUTE: N24    Spud: 12/16/1974    WINS No.: 02094    AFE/WO#: 2098195    API#: 0512308240

GL: 4896    KB: 4906    MTD: 7801    TVD: 7801    LOG MD:    PBMD: 7755    PBTVD:

Directions: CR 32 & CR 17, W 1 1/10, S 2/10 INTO    DITCH EAST OF WELLHEAD

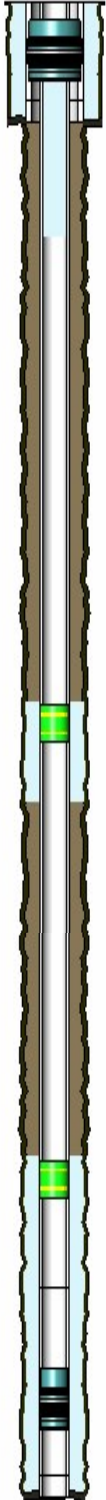

HOLE SECTIONS		Size	Top	Btm	TD Date	
SURFACE		12.25	10	230	12/18/1974	
PRODUCTION		7.88	230	7800	12/23/1974	

TUBULARS	Tool Type	Joints	Size	Weight	Grade	Thread	Top D	Bottom D
SURFACE CASING	Casing	5	8.62	24.00	J-55		10	224
	Casing	1	8.62				224	226
PRODUCTION CASING	Casing	217	4.50	10.50	K-55		10	7048
	Casing	23	4.50	11.60			7048	7796
	Casing	1	4.50				7796	7798
BRIDGE PLUG	Bridge Plug	1	4.50				7560	7562
CAST IRON CEMENT RETAINER								
	Cement Retainer	1	4.50				6485	6487
CAST IRON CEMENT RETAINER								
	Cement Retainer	1	4.50				3870	3872
BRIDGE PLUG	Bridge Plug	1	8.67				100	102

CEMENT JOBS	Stage	Sacks	Cement Jobs		Top D	Btm D	cbl
SURFACE CASING	PRIM CMT 1ST STAGE	200	Lead	FRESH WATER	10	226	No
PRODUCTION CASING	PRIM CMT 1ST STAGE	200	Lead	FRESH WATER	6638	7800	No
PRODUCTION CASING	SQUEEZE JOB	120	LEAD	FRESH WATER	6450	6850	No
PRODUCTION CASING	SQUEEZE JOB	225	TAIL	FRESH WATER	3840	4240	No
PRODUCTION CASING	REMEDIAL CEMENT	310	TAIL	FRESH WATER	103	950	No

PERFORATIONS						
Formation	Zone	Top	Btm	Date	Reason	Comments
Unknown		3840	3841	04/24/2014	CEMENT SQUEEZE	
Unknown		4240	4241	04/24/2014	CEMENT SQUEEZE	
NIOBRARA		6450	6451	04/23/2014	CEMENT SQUEEZE	
NIOBRARA		6850	6851	04/23/2014	CEMENT SQUEEZE	
J SAND		7650	7678	01/18/1975	PRODUCTION	

Comments: