


**WELL NAME:** Hnizdil #1-14  
**OPERATOR:** Gemini Energy Resources Inc  
**COMP ZONE:** \_\_\_\_\_  
**LOCATION:** 8N 60W S14 SW SE

**COUNTY:** Weld  
**STATE:** Colorado  
**API :** 05-123-10557

**SPUD:** 11/15/82  
**P&A:** 3/9/83  
**GL:** 4,930'

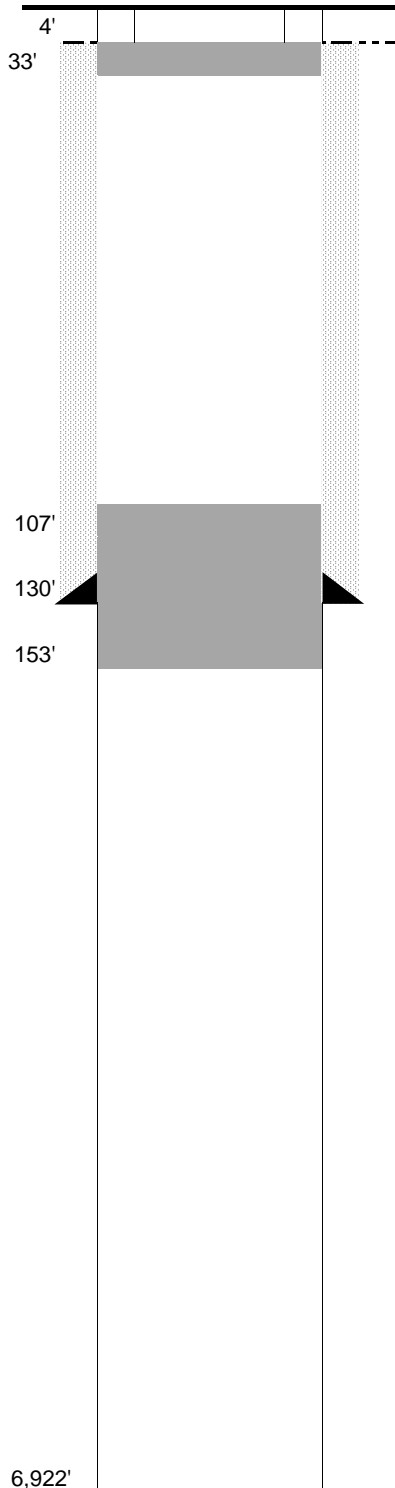

**SURFACE CASING**

DEPTH: 130' SIZE: 8.625" GRADE: \_\_\_\_\_ WT (#/ft): 24.0  
CEMENT: 130 sx of cement  
COMMENTS: \_\_\_\_\_

**PRODUCTION CASING**

DEPTH: \_\_\_\_\_ SIZE: \_\_\_\_\_ GRADE: \_\_\_\_\_ WT (#/ft): \_\_\_\_\_  
CEMENT: \_\_\_\_\_ TOC: \_\_\_\_\_  
COMMENTS: \_\_\_\_\_

PERFS: \_\_\_\_\_ - \_\_\_\_\_ PROD ZONE 1: \_\_\_\_\_  
PERFS: \_\_\_\_\_ - \_\_\_\_\_ ZONE 2: \_\_\_\_\_  
PERFS: \_\_\_\_\_ - \_\_\_\_\_ ZONE 3: \_\_\_\_\_

**PLUGGING REPORT**

ZONE 1 CIBP: \_\_\_\_\_ CMT: \_\_\_\_\_ OTHER: \_\_\_\_\_  
2 CIBP: \_\_\_\_\_ CMT: \_\_\_\_\_ OTHER: \_\_\_\_\_  
3 CIBP: \_\_\_\_\_ CMT: \_\_\_\_\_ OTHER: \_\_\_\_\_

RECOVERED: \_\_\_\_\_ SIZE: \_\_\_\_\_  
CMT 1: 153' - 107' COMMENT: 25 sx of Cement  
CMT 2: 33' - 0' COMMENT: 10 sx of Cement  
CMT 3: \_\_\_\_\_ - \_\_\_\_\_ COMMENT: \_\_\_\_\_

OTHER: cut all casing strings 4' below ground level, weld on plate

**FORMATIONS:**

NIOBRARA: 6,116'  
FORT HAYS 6,360'  
CODELL 6,414'  
D SAND 6,830'  
D SILT 6,899'  
J SAND 6,916'