

Rangely Weber Sand Unit

Well Details:	
STATE & CO	CO - Rio Blanco
TWNS & RNG	T2N & R103W
SECTION	(SWSW) 14
API	510360053
CHEVNO	DE5771

Casing Details:	
Type	Depth
KB	KB
GL	GL
16 in. 55 #/ft, J-55	0 - 36,' 50 sxs cmt
10.75 in. 40.5 #/ft, J-55	0 - 702,' 500 sxs cmt
7 in. 26 #/ft, N-80	0 - 31,' sxs cmt
7 in. 23 #/ft, J-55	31 - 5593,' sxs cmt
7 in. 26 #/ft, N-80	5593 - 6250,' 1250 sxs cmt
Perfs, Top	0
Perfs, Btm	0
PBTD	6650
TD	6650

Formation	Depth
Niobrara	2373
Frontier	3290
Frontier Snd	3360
Mowry	3540
Dakota	3630
Morrison	3720
Curtis	4437
Entrada	4532
Carmel	4675
Navajo	4722
Chinle	5363
Shinarump	5481
Moenkopi	5553
Weber	6234

GOC_CALC	5827		
Weber 1a	6235	168	0
Weber 2	6403		
Weber 3a	6413	84	0
Weber 4	6497		
Weber 5a	6517	50	0
Weber 6	6567		
Weber 7a	6600	###	0
Weber 8	0		
Weber 9a	0	0	0
Weber 10	0		
Weber 11a	0	0	0
		###	0
OWC_CALC	6597		

KB KB
GL GL
16 in. 55 #/ft, J-55
0 - 36,' 50 sxs cmt

10.75 in. 40.5 #/ft, J-55
0 - 702,' 500 sxs cmt


7 in. 26 #/ft, N-80
0 - 31,' sxs cmt

7 in. 23 #/ft, J-55
31 - 5593,' sxs cmt

7 in. 26 #/ft, N-80
5593 - 6250,' 1250 sxs cmt

OPEN HOLE
6250' - 6650'

PBTD 6650
TD 6650

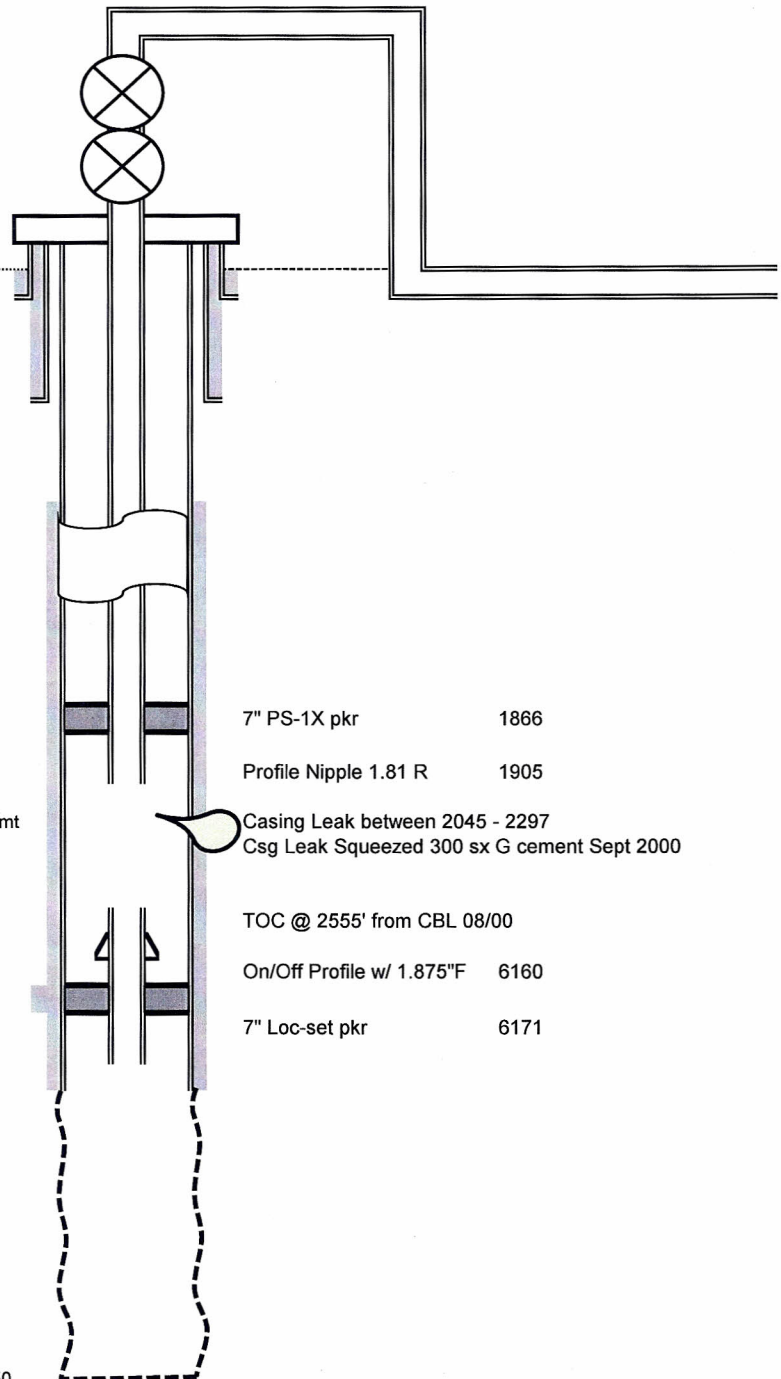

Notes:

- 1-
- 2-
- 3-