WELL NAME:	**Rainbow-Shull #1**	**COUNTY:**	Weld	**SPUD:**	1/8/76
OPERATOR:	Toltek Drilling	**STATE:**	Colorado	**P&A:**	2/3/76
COMP ZONE:	N/A	**API :**	05-123-08606	**GL:**	4,868'
LOCATION:	9N 59W S31 SW NW				

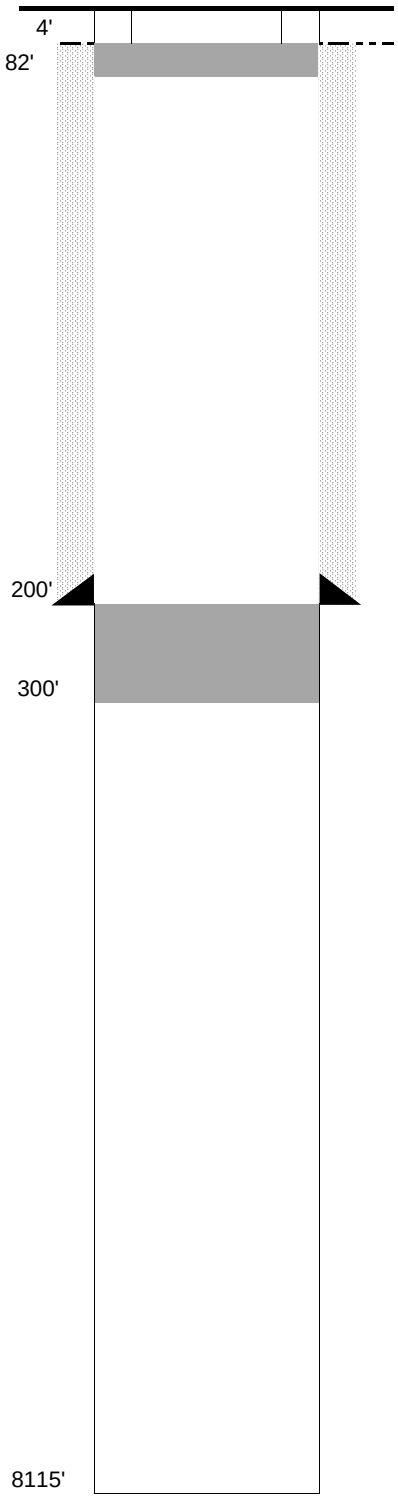

SURFACE CASING

DEPTH: 200' SIZE: 8.625" GRADE: _____ WT (#/ft): 24.0

CEMENT: 200 sx of class G cmt.

COMMENTS: _____

PRODUCTION CASING

DEPTH: _____ SIZE: _____ GRADE: _____ WT (#/ft): _____

CEMENT: _____ TOC: _____

COMMENTS: _____

PERFS: _____ - _____ PROD ZONE 1: _____

PERFS: _____ - _____ ZONE 2: _____

PERFS: _____ - _____ ZONE 3:

PLUGGING REPORT

ZONE 1 CIBP: _____ CMT: _____ OTHER: _____

2 CIBP: _____ CMT: _____ OTHER: _____

3 CIBP: _____ CMT: _____ OTHER: _____

RECOVERED: _____ SIZE: _____

CMT 1: 300' - 200' COMMENT: 30 sx cement

CMT 2: 0' - 82' COMMENT: 10 sx cement

CMT 3: _____ - _____ COMMENT: _____

OTHER: Metal plate welded on casing collar

FORMATIONS:

NIOBRARA:	5,987'
FORT HAYS	
CARLILE	6,319'
D SAND	6,736'
D SILT	6,800'
J SAND	6,820'
LAKOTA	7,052'
LYONS	7,972'