


WELL LOCATION FOR EAST CHEYENNE GAS STORAGE, LLC

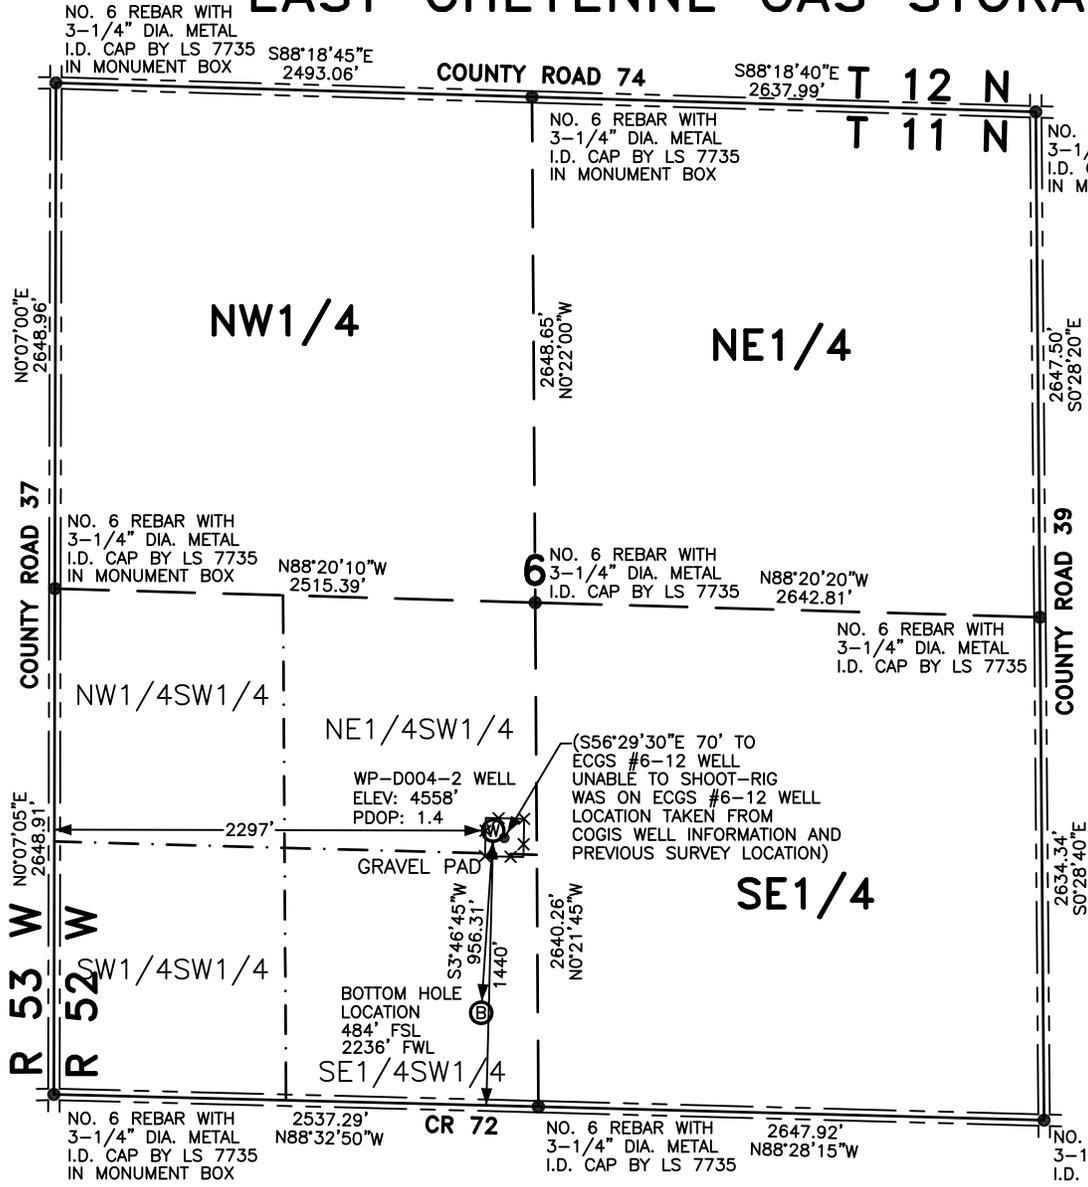

NOTES

- BEARINGS SHOWN HEREON ARE BASED UPON RTK GPS OBSERVATIONS
- SEE IMPROVEMENT PLAT FOR IMPROVEMENTS WITHIN 600' OF LOCATION.
- USGS QUAD MAP: PADRONI NW, COLO.
- ELEVATIONS BASED ON NAVD 1988
- ALL DISTANCES TO SECTION LINES ARE MEASURED PERPENDICULAR TO AND ARE AT RIGHT ANGLES TO SAID SECTION LINES.

LEGEND

- FIELD SURVEYED WELL LOCATION
- FIELD SURVEYED BOTTOM HOLE LOCATION
- ROAD
- FENCE

THIS WELL LOCATION PLAT HAS BEEN PREPARED FOR EAST CHEYENNE GAS STORAGE, LLC, TO LOCATE THE WP-D004-2 WELL BEING 2297 FEET FROM THE WEST LINE AND 1440 FEET FROM THE SOUTH LINE IN THE NE1/4SW1/4 OF SECTION 6, TOWNSHIP 11 NORTH, RANGE 52 WEST OF THE 6TH P.M., LOGAN COUNTY, COLORADO. THE SURFACE ELEVATION AT THIS POINT IS 4558 FEET. THE BOTTOM HOLE LOCATION PROVIDED BY THE CLIENT IS TO BE 2236' FROM THE WEST LINE AND 484' FROM THE SOUTH LINE OF SECTION 6, TOWNSHIP 11 NORTH, RANGE 52 WEST OF THE 6TH P.M., LOGAN COUNTY, COLORADO. THIS IS NOT A LAND SURVEY PLAT.

DATUM	WELL LOCATION		BOTTOM HOLE LOCATION	
	LATITUDE	LONGITUDE	LATITUDE	LONGITUDE
NAD83	40.95312N	103.22064W	40.95050N	103.22088W
NAD27	40.95314N	103.22016W	40.95052N	103.22039W



LEIBERT-McATEE & ASSOCIATES, INC.
P.O. BOX 442 615 SOUTH TENTH AVENUE
STERLING, CO 80751 970-522-1960

FIELD DATE: 6-7-14	DWG DATE: 6-9-14	GPS OPERATOR: DARREN VEAL
WP-D004-2	DWG NO. 687-14	SHEET 1 OF 1

