


After Replug Schematic:

8-5/8 24# K55 Surface
Set @ 206' MD

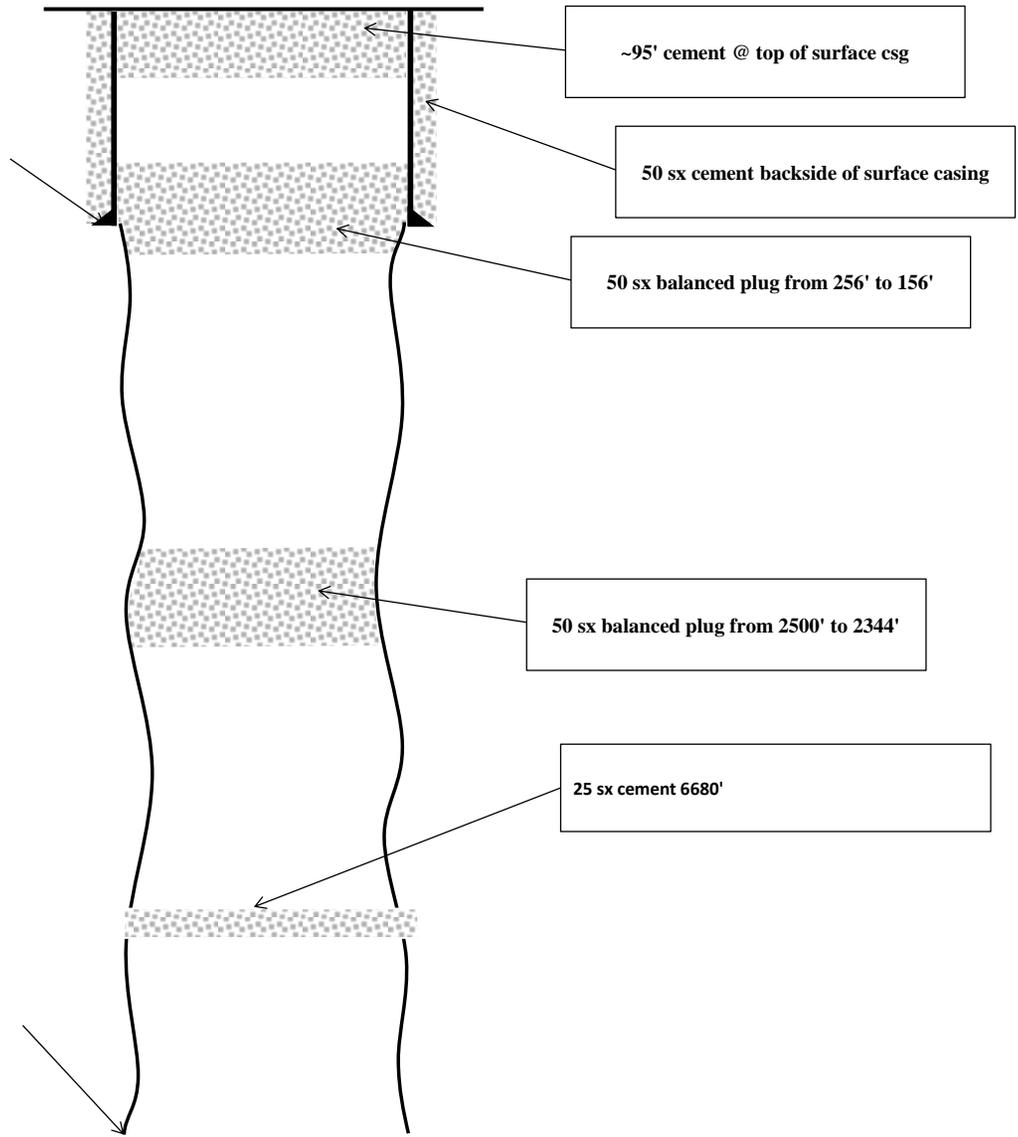

7 7/8" OH
To 6695' MD