




Lat40°, Inc. 1635 Foxtrail Drive, Suite 325 Loveland, CO 970-776-3321

PLUGGED & ABANDONED WELL EXHIBIT

THIS MAP DOES NOT REPRESENT A BOUNDARY SURVEY

SECTION: 10
TOWNSHIP: 5N
RANGE: 61W

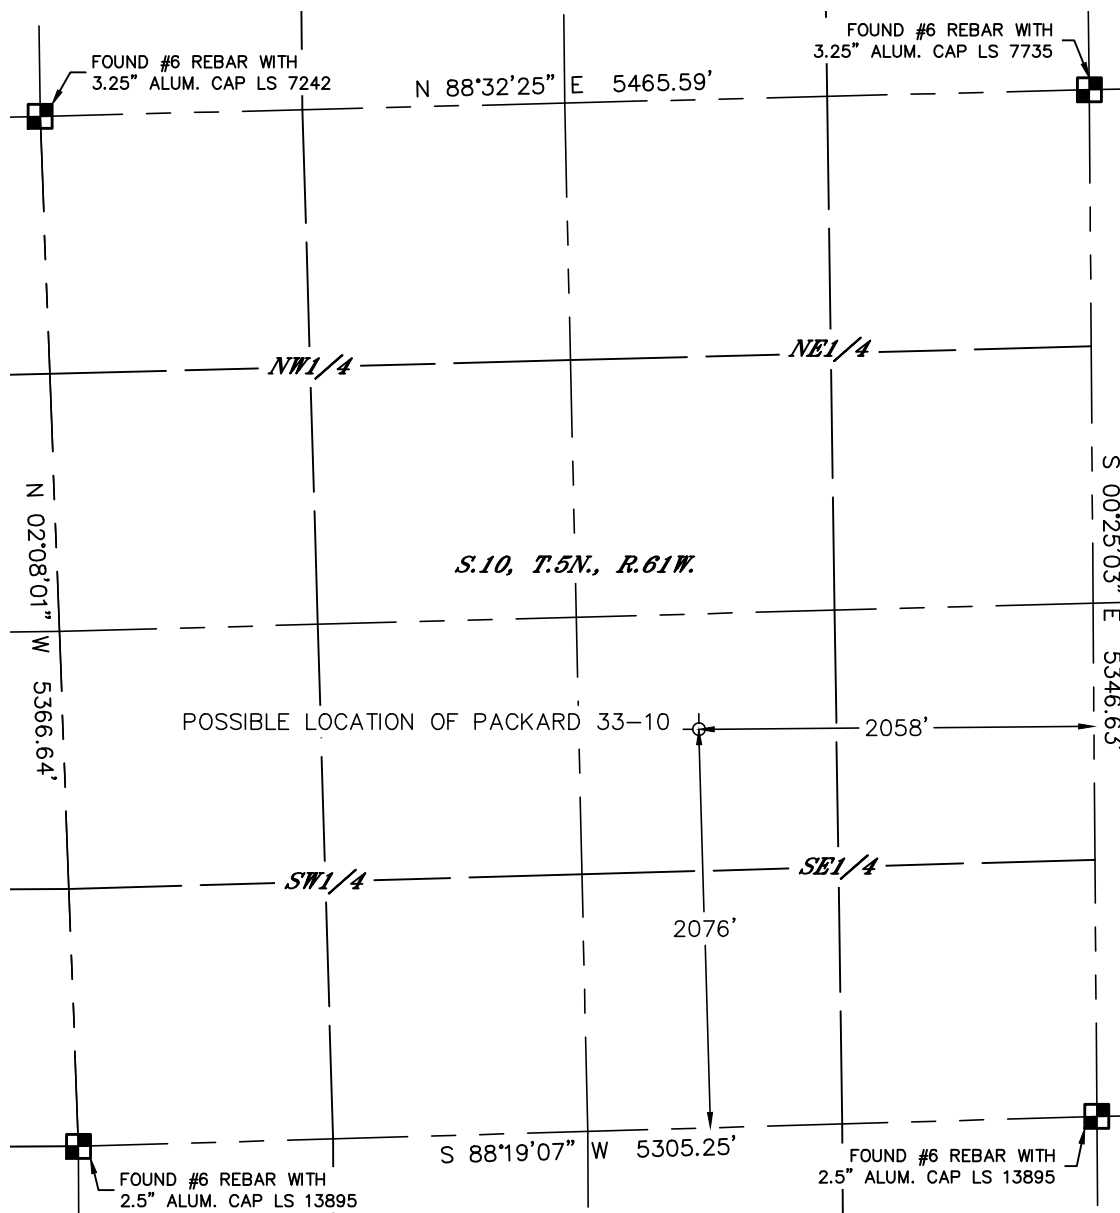

SURFACE LOCATION

LAT: 40.41410°N
LONG: 104.19253°W
PDOP: 1.8
ELEV: 4688'
1/4,1/4: NW1/4SE1/4

SURFACE DESCRIPTION

FOUND 10" STEEL PIPE FILLED WITH CONCRETE, FLUSH WITH GRADE. SET ORANGE LATH.

LEGEND

- = ALIQUOT MONUMENT AS DESCRIBED
- = CALCULATED POSITION

DATE: 1/30/2014
PROJECT#: 2013173



Lat40°, Inc. 1635 Foxtrail Drive, Suite 325 Loveland, CO 970-776-3321

P&A WELL LOCATION PICTURES

PACKARD 33-10

SECTION: 10
TOWNSHIP: 5N
RANGE: 61W

DATE: 1/27/2014



VIEW NORTH



VIEW WEST



VIEW EAST



VIEW SOUTH

DATE: 1/30/2014
PROJECT#: 2013173