


PACKARD 33-10

1980 FSL1980 FEL NWSE 10 5N 61W 6th PM
Lat 40.413937 Long -104.192304 (from footages)
Weld County, Colorado
API #05-123-10436

Spud date 11/7/1981

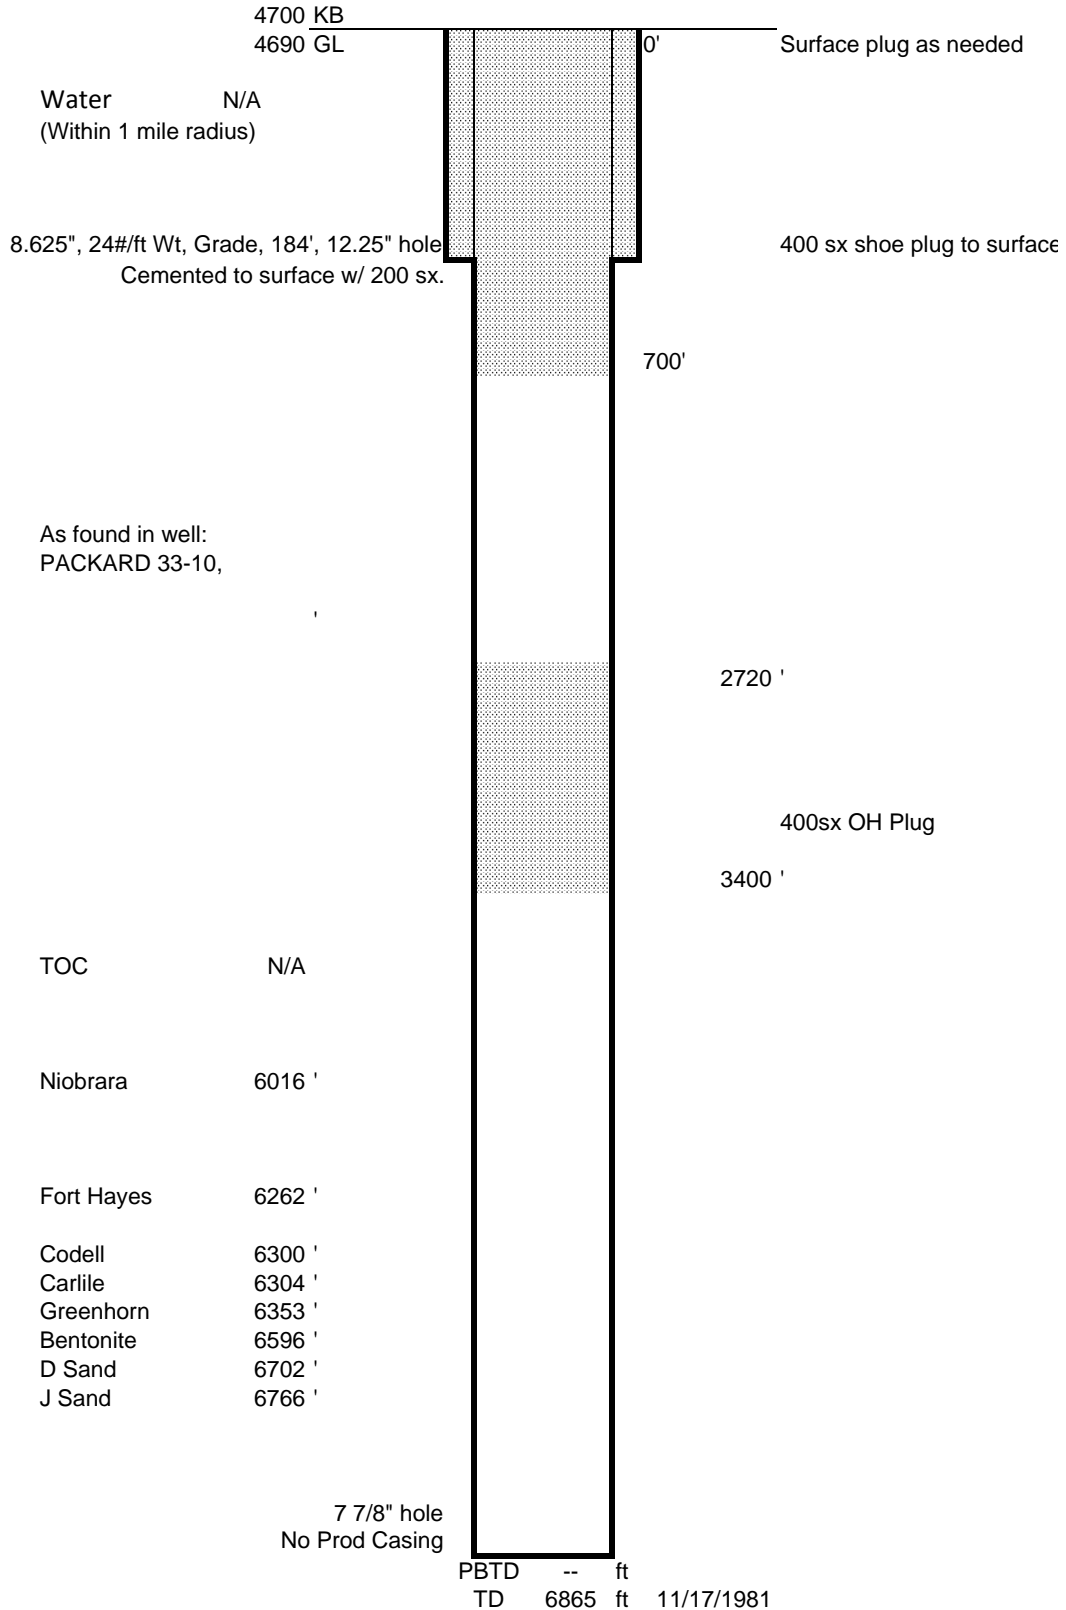

Updated 5/14/2014 oc