





Lat40°, Inc. 1635 Foxtrail Drive, Suite 325 Loveland, CO 970-776-3321

# PLUGGED & ABANDONED WELL EXHIBIT

THIS MAP DOES NOT REPRESENT A BOUNDARY SURVEY

SECTION: 15  
TOWNSHIP: 5N  
RANGE: 61W

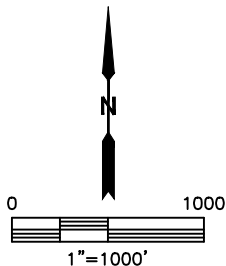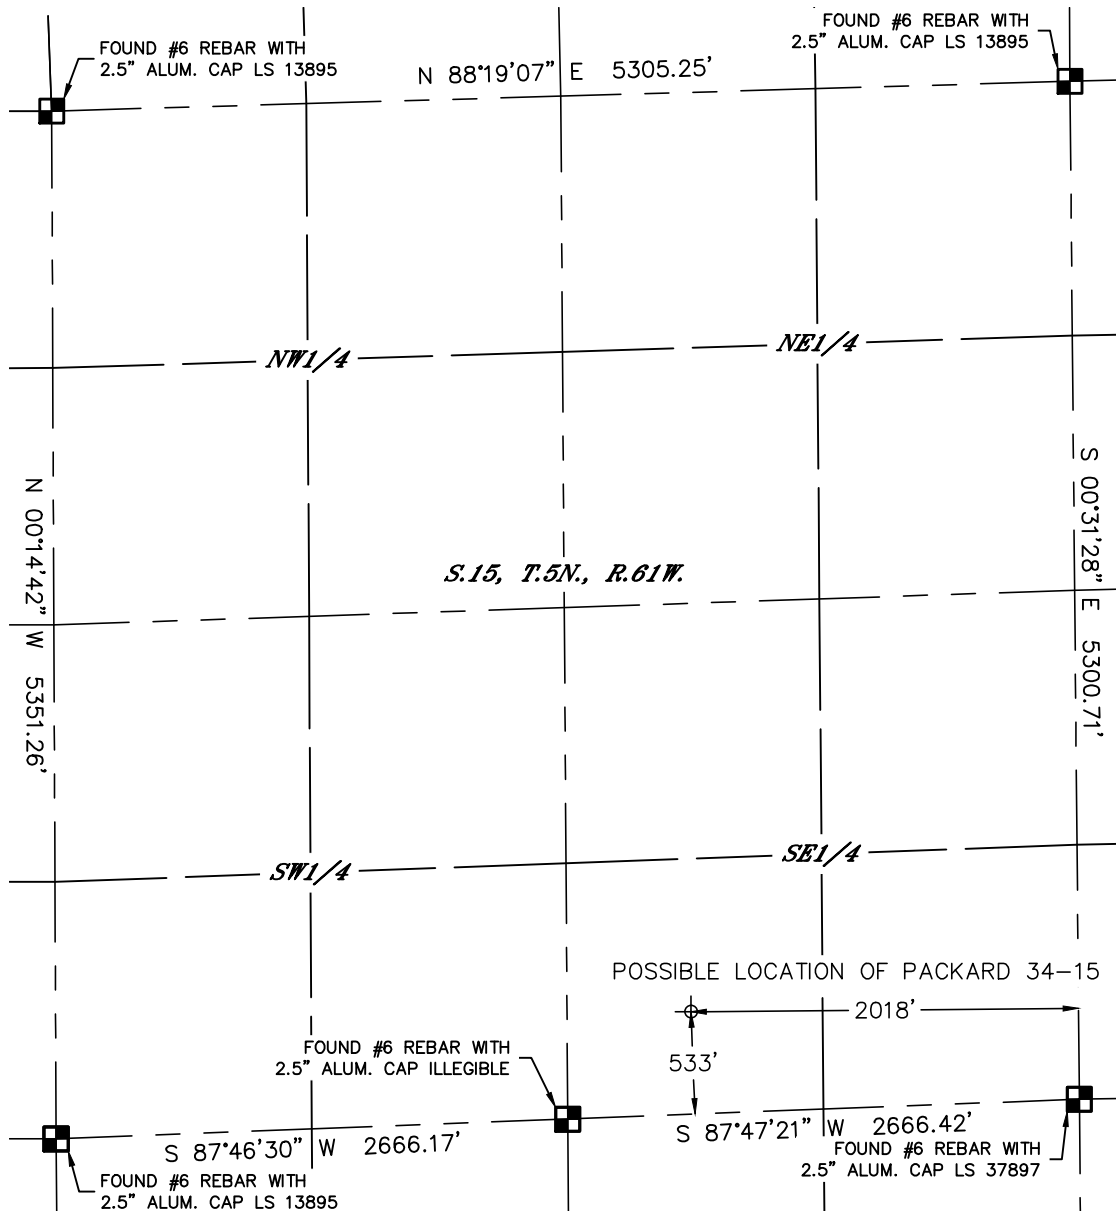

SURFACE LOCATION  
LAT: 40.39527°N  
LONG: 104.19253°W  
PDOP: 2.6  
ELEV: 4673'  
1/4,1/4: SW1/4SE1/4

SURFACE DESCRIPTION  
FOUND A 'T' POST SET IN GROUND. GOT STRONG METAL DETECTOR SIGNAL WITHIN 20' OF 'T' POST. A SMALL DISTURBED AREA IN THE IMMEDIATE VICINITY. STRAPPED ORANGE LATH TO POST.

## LEGEND

- = ALIQUOT MONUMENT AS DESCRIBED
- = CALCULATED POSITION

DATE: 2/28/2014  
PROJECT#: 2013173



Lat40°, Inc. 1635 Foxtrail Drive, Suite 325 Loveland, CO 970-776-3321

## P&A WELL LOCATION PICTURES

PACKARD 34-15

SECTION: 15  
TOWNSHIP: 5N  
RANGE: 61W

DATE: 2/13/2014



VIEW NORTH



VIEW WEST



VIEW EAST



VIEW SOUTH

DATE: 2/28/2014  
PROJECT#: 2013173