





Lat40°, Inc. 1635 Foxtrail Drive, Suite 325 Loveland, CO 970-776-3321

# PLUGGED & ABANDONED WELL EXHIBIT

THIS MAP DOES NOT REPRESENT A BOUNDARY SURVEY

SECTION: 15  
TOWNSHIP: 5N  
RANGE: 61W

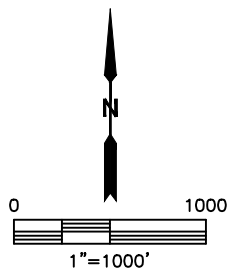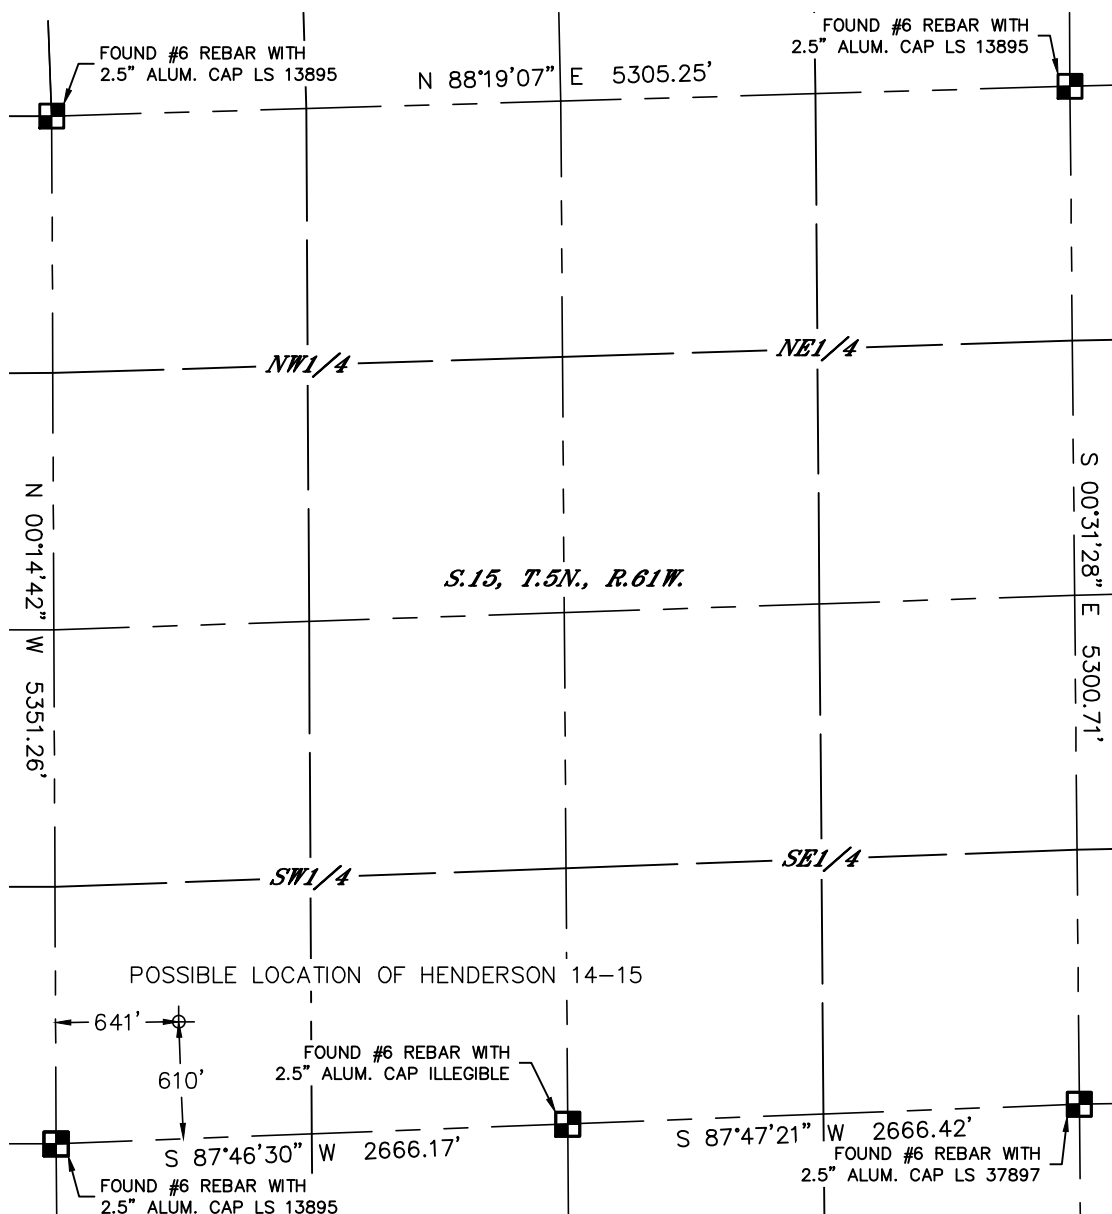

## SURFACE LOCATION

LAT: 40.39530°N  
LONG: 104.20211°W  
PDOP: 2.1  
ELEV: 4649'  
1/4,1/4: SW1/4SW1/4

## SURFACE DESCRIPTION

FOUND A 10" DIA. STEEL PIPE FLUSH WITH GROUND, IN A LOW AREA. APPROXIMATELY 600' NORTH AND 650' EAST OF FENCE LINES. SET ORANGE LATH.

## LEGEND

- = ALIQUOT MONUMENT AS DESCRIBED
- = CALCULATED POSITION

DATE: 2/28/2014  
PROJECT#: 2013173



Lat40°, Inc. 1635 Foxtrail Drive, Suite 325 Loveland, CO 970-776-3321

## P&A WELL LOCATION PICTURES

HENDERSON 14-15

SECTION: 15  
TOWNSHIP: 5N  
RANGE: 61W

DATE: 1/27/2014



VIEW NORTH



VIEW WEST



VIEW EAST



VIEW SOUTH

DATE: 2/28/2014  
PROJECT#: 2013173