


SEC. 18, T. 6 S., R. 96 W. OF THE 6TH P.M. Chevron E18-696
Pad Location

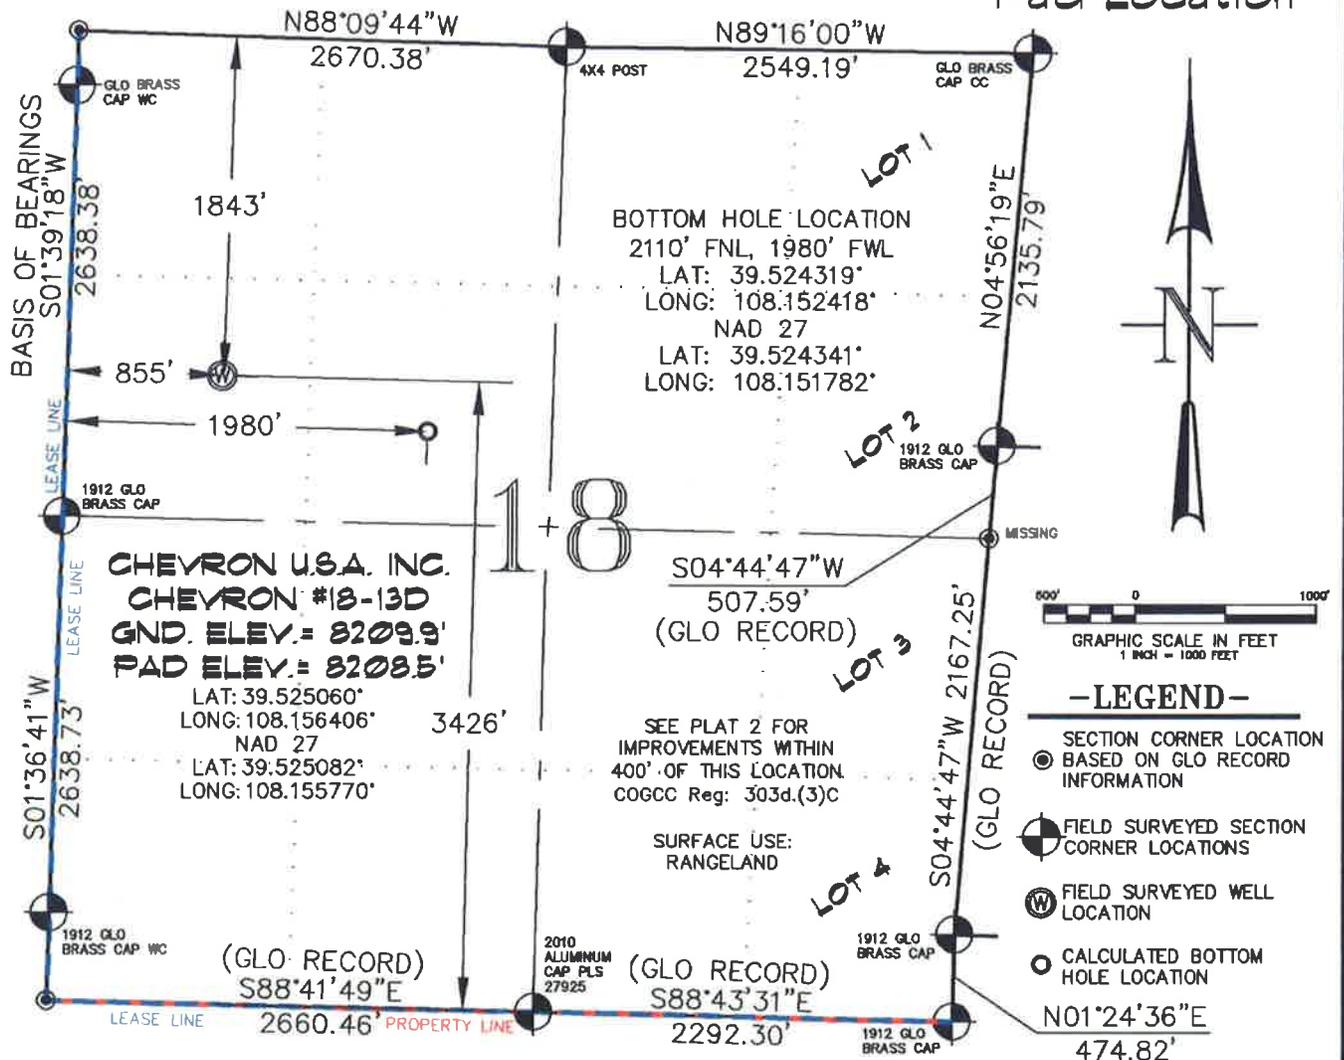

THIS WELL LOCATION PLAT WAS PREPARED FOR BERRY PETROLEUM COMPANY TO LOCATE THE CHEVRON #18-13D WELL, 1843 FEET FROM THE NORTH LINE AND 855 FEET FROM THE WEST LINE IN THE SW1/4 NW1/4 OF SECTION 18, T. 6 S., R. 96 W. OF THE 6TH P.M. GARFIELD COUNTY, COLORADO.

REFERENCE NOTES

- 1) T. 6 S., R. 96 W., 6TH P.M. GLO PLAT.
- 2) U.S.G.S. QUAD: CIRCLE DOT GULCH, CO
- 3) ELEVATIONS BASED ON N.A.V.D. 1988
- 4) LATITUDES AND LONGITUDES ARE BASED ON NAD 83, COLORADO CENTRAL ZONE.
- 5) GPS OPERATOR ROBERT WOOD, OBSERVED A PDPF OF 2.0.
- 6) ALL GPS OBSERVATIONS ARE IN COMPLIANCE WITH COGCC RULE NO. 215.
- 7) SURFACE AND BOTTOM HOLE LOCATIONS ARE MEASURED 90° FROM SECTION LINES.

SURVEYOR'S CERTIFICATE

I, George R. Bauer: a Professional Land Surveyor in the State of Colorado do hereby certify that this Survey was made under my direct supervision, and that this Plat represents said Survey.

George R. Bauer
 27925
 4/15/10

COLORADO P.L.S. 27925



CONSTRUCTION SURVEYS, INC.
 2012 SUNRISE BLVD.
 SILT, CO 81652
 (970)876-5753

VIEW: 1H

SURVEYED: 06/09/06	SCALE: 1" = 1000'
DRAFTED: 04/12/10	DWG: BERRY\CHEV E18-696
CHECKED: 04/14/10	SHEET: 1 of 11