



Physical Address: 345 Comanche St.
 Mail to: Box 384, Kiowa, CO 80117
 Ph. 303-621-8672 - Fax 303-621-7749
 www.highprairiesurvey.com

Job # 14193 Hagemann #31-19-1s44w

Inv # 3235


High Prairie Surveying of Kiowa, Colorado, in accordance with a request from **Augustus Energy Resources LLC**, has determined the location of **Hagemann #31-19-1s44w** to be **303 feet FNL**, and **2229 feet FEL**, (90° off Section lines) of **SECTION 19**, Township **1s**, Range **44w** of the 6th Principal Meridian, **Yuma County**, Colorado.

Date: Staked on 06/12/14 drawn on 06/17/14.

Re: Staked by Elijah Frane
Drawn: Drawn by Dustin Cotter

Basis of Elevation Spot: USGS BM = E 25, PID = KJ0404, H-Order = Second, V-Order = Third, Stability = Unknown, P-DOP = 1.90, Sats = 8 US NAD 83 CO-C, Lat. = 39.93332, Long. = W102.37285 = 3927.3 gr. (65 Ft)

Notes: See Location Drawing for improvements within 500' of proposed well pad.
 The ground elevation at staked location = 3947.39' gr.
 This drawing does not represent a monumented survey or Land Survey Plat.

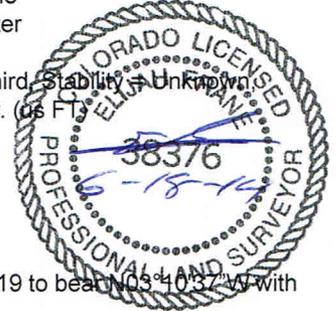


