


Hancock Gulch 1-15 CBM  
NE NE Section 15 T8S R98W Mesa County  
API# 05 077 08597

Wellbore geometry 6-12-14-

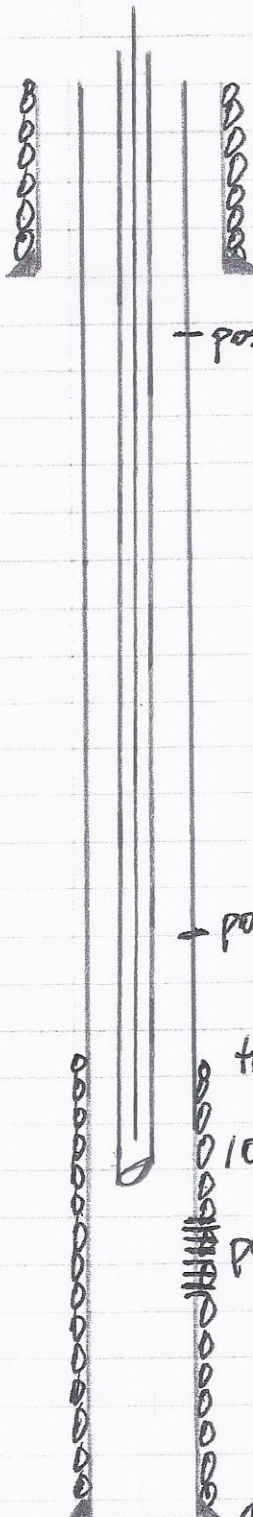

8 5/8" 24# 12 1/4" hole @ 112' 110sxs  
- possible casing leak 166'

Mesaverde	734'
Cameo Coal	3082'
Rollins	3408'

- possible casing leak 2375'-2405'

top of cement by CBL 2540'

105jts 2 7/8" tbg 126-3/4" sucker rods

perfs 3265'-3408'

4 1/2" 10.5# 7 7/8" hole @ 3530' 450sxs

Hancock Gulch 1-15 CBM  
 NE NE Section 15 T8S R9BW Mesa County  
 API# 05 077 08597

Plate welded on CSG stub

Proposed plugged wellbore

