

KERR-MCGEE OIL AND GAS ONSHORE LP

PERRIN HELEN R GU 1

SE SW 29 2N 67W -- --

WELD,COLORADO

05/29/2014

AREA: W1

ROUTE: W16 Spud: 05/01/1975

WINS No.: 74835

AFE/WO#: 2096669

API#: 0512308352

GL: 5046

KB: 5056

MTD: 8267


TVD: 8267

LOG MD:

PBMD: 8221

PBTVD: 8221

Directions: WCR 15 & WCR 16, N 1/8, E 1/4, N 1/8 INTO

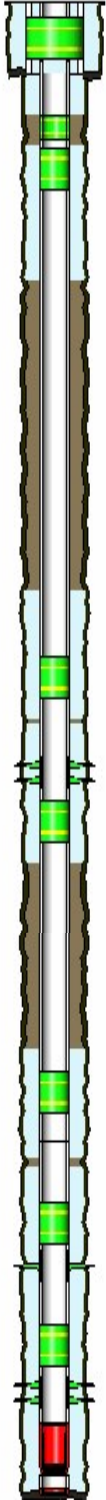

<u>HOLE SECTIONS</u>	<u>Size</u>	<u>Top</u>	<u>Btm</u>	<u>TD Date</u>				
SURFACE	12.25	10	215	05/01/1975				
PRODUCTION	7.88	215	8267	05/10/1975				
<u>TUBULARS</u>	<u>Tool Type</u>	<u>Joints</u>	<u>Size</u>	<u>Weight</u>	<u>Grade</u>	<u>Thread</u>	<u>Top D</u>	<u>Bottom D</u>
SURFACE CASING	Casing	5	8.63	24			10	212
PRODUCTION CASING	Casing	3	4.50	11.6			10	106
	Casing	10	4.50	10.5			106	545
	Cement Stage Too	1	4.50				545	548
	Casing	167	4.50	10.5			548	7139
	Casing	34	4.50	11.6			7139	8211
	Casing Float Shoe	1	4.50				8211	8212
	Casing	1	4.50	11.6			8212	8249
	Casing Guide Shoe	1	4.50				8249	8250
BRIDGE PLUG	CIBP With CMT Cap	1	4.50				7625	7627
BRIDGE PLUG	CIBP With CMT Cap	1	4.50				8060	8062
CAST IRON CEMENT RETAINER	Cement Retainer	1	4.50				6902	6904
CAST IRON CEMENT RETAINER	Cement Retainer	1	4.50				5033	5035
CAST IRON CEMENT RETAINER	Cement Retainer	1	4.50				618	620
CAST IRON CEMENT RETAINER	Cement Retainer	1	4.50				4440	4442
BRIDGE PLUG	Cast Iron Bridge Plu	1	8.63				90	92
<u>CEMENT JOBS</u>	<u>Stage</u>	<u>Sacks</u>	<u>Cement Jobs</u>		<u>Top D</u>	<u>Btm D</u>	<u>chl</u>	
SURFACE CASING	STAGE 1	200		G	10	215	No	
PRODUCTION CASING	STAGE 1				7326	8267	Yes	
	SQUEEZE 1	250		50/50 POZ-MIX	4156	4350	Yes	
	SQUEEZE 1	250		50/50 POZ-MIX	4156	4350	Yes	
	STAGE 2				10	545	Yes	
	SQUEEZE 2				4640	4921	Yes	
PRODUCTION CASING	SQUEEZE JOB	150	LEAD	FRESH WATER	6709	7260	No	
PRODUCTION CASING	SQUEEZE JOB	220	LEAD	FRESH WATER	4837	5200	No	
PRODUCTION CASING	SQUEEZE JOB	200	LEAD	FRESH WATER	3890	4600	No	
PRODUCTION CASING	SQUEEZE JOB	470	LEAD	FRESH WATER	600	1370	No	
SURFACE CASING	ABANDONMENT PLUC	23	LEAD	FRESH WATER	96	210	No	

KERR-MCGEE OIL AND GAS ONSHORE LP

PERRIN HELEN R GU 1

SE SW 29 2N 67W -- --

WELD,COLORADO

05/29/2014

AREA: W1

ROUTE: W16 Spud: 05/01/1975

WINS No.: 74835

AFE/WO#: 2096669

API#: 0512308352

GL: 5046KB: 5056MTD: 8267TVD: 8267LOG MD:PBMD: 8221PBTVD: 8221Directions:

WCR 15 & WCR 16, N 1/8, E 1/4, N 1/8 INTO

PERFORATIONS

<u>Formation</u>	<u>Zone</u>	<u>Top</u>	<u>Btm</u>	<u>Date</u>	<u>Reason</u>	<u>Comments</u>
		600	601	04/10/2014	CEMENT SQUEEZE	
		1370	1371	04/10/2014	CEMENT SQUEEZE	
SUSSEX		4350	4350	09/27/1985	CEMENT SQUEEZE	
		4400	4401	04/10/2014	CEMENT SQUEEZE	
		4600	4601	04/10/2014	CEMENT SQUEEZE	
SUSSEX		4920	4921	09/26/1995	CEMENT SQUEEZE	
		5000	5001	04/09/2014	CEMENT SQUEEZE	
		5200	5201	04/09/2014	CEMENT SQUEEZE	
		6860	6861	04/08/2014	CEMENT SQUEEZE	
		7260	7261	04/08/2014	CEMENT SQUEEZE	
CODELL		7688	7710	10/02/1995	PRODUCTION	
J SAND		8125	8146	06/26/1975	PRODUCTION	

Comments: