


Well Name: LATHAM 02-01

VERTICAL - ORIGINAL HOLE, 6/24/2014 4:20:23 PM

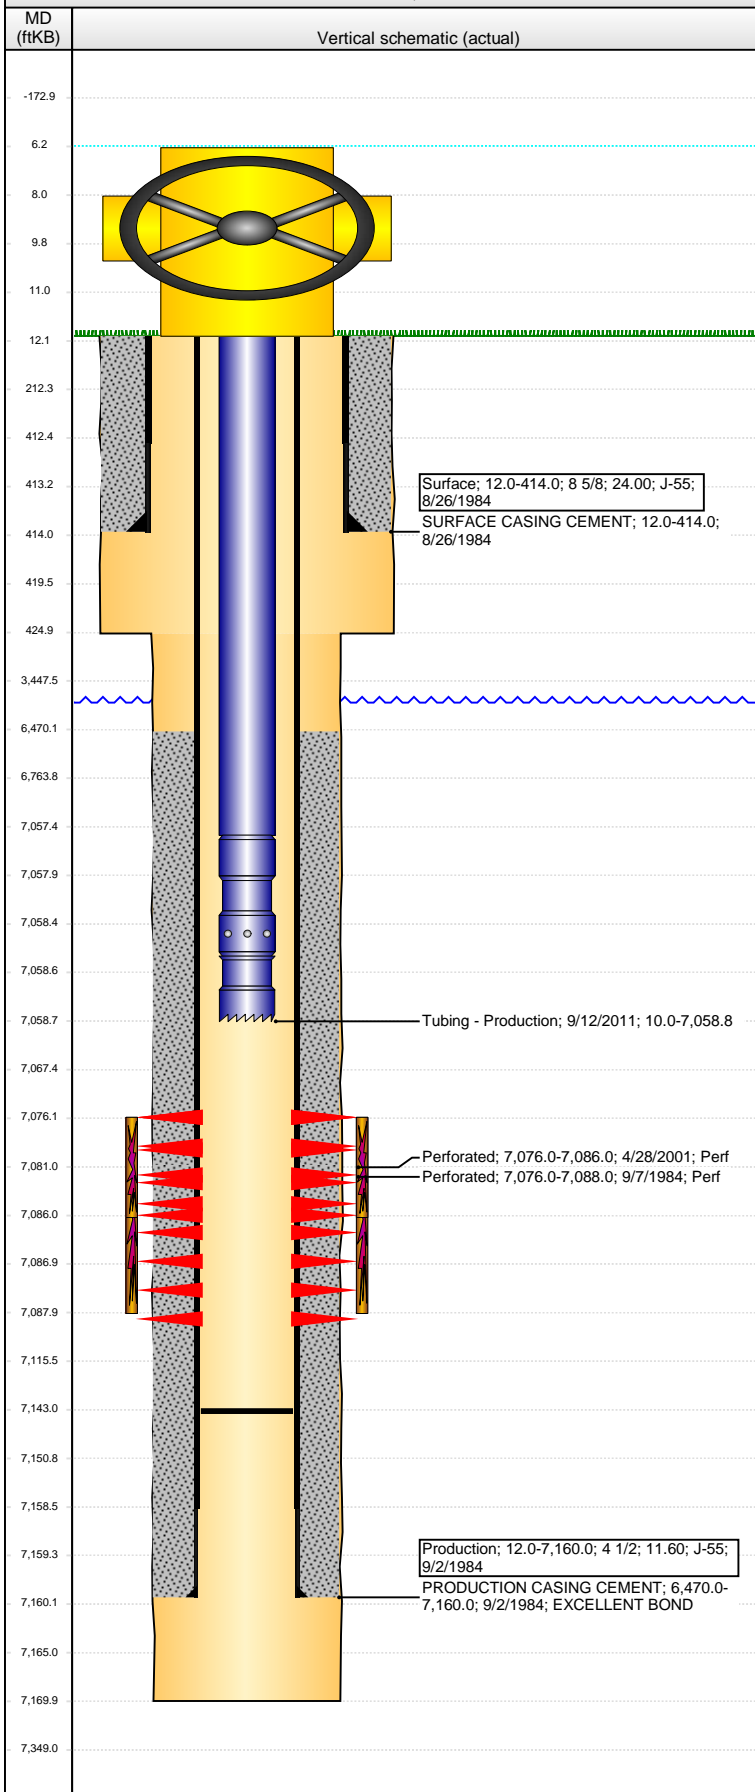

Well Header

API	Business Unit	District	Well Config
05-123-11952	WATTENBERG	15	VERTICAL
Original KB Elevation (ft)	KB - GL / MSL (ftKB)	Spud Date	P & A Date
4,718.00	12.00	8/25/1984	

Comment
DV TOOL @ +/-2980, BUT NOT CEMENTED

Directions To Well

Congressional Location

Quarter 1	Quarter 2	Quarter 3	Quarter 4	Section	Township	Twntshp N...	Range	Rng E/W Dir
		NE	SE	2	4	N	65	W

Bottom Hole Location

North-South Distance (ft)	From N or S Line	East-West Distance (ft)	From E or W Line

Plug Back Total Depths

Date	Depth (ftKB)	Method	Com
9/5/1984	7,120.0	CASED HOLE LOG	CBL DEPTH LOGGER
9/12/2011	7,143.0	TAG	MOST RECENT C/O TO PBDT

Wellbore Sections

Section Des	Size (in)	Act Top, MD (ftKB)	Act Btm, MD (ftKB)
SURFACE	12 1/4	12.0	425.0
PRODUCTION	7 7/8	425.0	7,170.0

Zone Statuses

Zone Name	Status Date	Status	Job
CODELL	10/6/1984	PR	DRILLING/COMPLETION - ORIGINAL, 8/25/1984 00:00
CODELL	5/3/2001	PR	RE-FRAC, 4/27/2001 00:00

Casing Strings

Surface, 414.0ftKB

Casing Description	Run Date	OD (in)	Wt/Len (l...)	Grade	Top, MD (ft...)	MD (ftKB)
Surface	8/26/1984	8 5/8	24.00	J-55	12.0	414.0

Production, 7,160.0ftKB

Casing Description	Run Date	OD (in)	Wt/Len (l...)	Grade	Top, MD (ft...)	MD (ftKB)
Production	9/2/1984	4 1/2	11.60	J-55	12.0	7,160.0

Cement

Description	Top Depth (ftKB)	Bottom Depth (ftKB)
SURFACE CASING CEMENT	12.0	414.0
PRODUCTION CASING CEMENT	6,470.0	7,160.0

Tubing Components

Item Des	OD (in)	Wt (lb/ft)	Grade	Jts	Len (ft)	Btm (ftKB)	Btm (TVD) (ftKB)
EUE 8rd Tubing	2 3/8	4.70	J-55	219	7,047.50	7,057.5	
Pump Seating Nipple	2 3/8			1	1.00	7,058.5	
Notched collar	2 3/8			1	0.30	7,058.8	

Perforation Data

Zone	Bnch/St g	Entered Shot Total	Top (ftKB)	Btm (ftKB)	Date
CODELL, ORIGINAL HOLE			7,076.00	7,088.00	9/7/1984
CODELL, ORIGINAL HOLE			7,076.00	7,086.00	4/28/2001

Stimulations & Treatments

Date	Zone	Primary Job Type
9/12/1984	CODELL, ORIGINAL HOLE	DRILLING/COMPLETION - ORIGINAL
Technical Result	Tech Result Details	Tech Result Note

Comment

Date	Zone	Primary Job Type
5/1/2001	CODELL, ORIGINAL HOLE	RE-FRAC
Technical Result	Tech Result Details	Tech Result Note

Comment

Other In Hole

Run Date	Des	OD (in)	Top (ftKB)	Btm (ftKB)

Logs

Date	Type	Top, MD (ftKB)	Btm, MD (ftKB)
9/1/1984	COMPENSATED DENSITY	2,750.0	7,180.0

Well Name: LATHAM 02-01

VERTICAL - ORIGINAL HOLE, 6/24/2014 4:20:25 PM

Logs

Date	Type	Top, MD (ftKB)	Btm, MD (ftKB)
9/1/1984	INDUCTION	300.0	7,180.0
9/5/1984	CEMENT BOND	6,340.0	7,090.0
9/24/2013	GYRO	12.0	6,900.0

