

**KERR-MCGEE OIL AND GAS ONSHORE LP**

**CANNON RED W 15-12**

**NW SW 15 2N 66W -- --**

**WELD,COLORADO**

**06/25/2014**

**AREA: E3**

**ROUTE: E32**

**Spud: 12/09/1992**

**WINS No.: 22355**

**AFE/WO#: 2098371**

**API#: 0512316515**

**GL: 4982**

**KB: 4992**

**MTD:**


**TVD:**

**LOG MD:**

**PBMD: 7664**

**PBTVD:**

**Directions: CR 20 & CR 31 E 1/10, N 20' INTO DROP GATE, E 1/10, N 3/10, W INTO ON LOC: 15-11, 15-13, 15-14, 15-23**

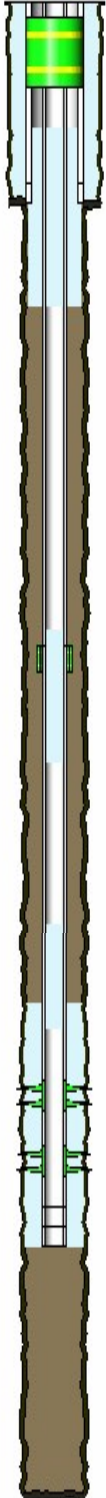

<u>HOLE SECTIONS</u>	<u>Size</u>	<u>Top</u>	<u>Btm</u>	<u>TD Date</u>
SURFACE	12.25	10	800	12/10/1992
PRODUCTION	7.88	800	7681	12/14/1992

<u>TUBULARS</u>	<u>Tool Type</u>	<u>Joints</u>	<u>Size</u>	<u>Weight</u>	<u>Grade</u>	<u>Thread</u>	<u>Top D</u>	<u>Bottom D</u>
Surface	Casing	19	8.62	24.00			10	798
	Casing	1	8.62				798	800
Production	Casing	237	3.50	9.30			10	7660
	Casing	1	3.50				7660	7661
	Casing	1	3.50				7661	7662
Production	Casing	98	3.50	7.70	N-80		10	4117
	Casing Patch	1	5.50				4117	4124
BRIDGE PLUG	Cast Iron Bridge Plu	1	8.63				80	83

<u>CEMENT JOBS</u>	<u>Stage</u>	<u>Sacks</u>	<u>Cement Jobs</u>	<u>Top D</u>	<u>Btm D</u>	<u>cbl</u>
Surface		560	Surface C	10	801	No
Production		215	Lead	4304	0	No
		385	Tail	6600	7662	No
Production	ABANDONMENT PLUC	25	LEAD FRESH WATER	6014	6800	No
Production	ABANDONMENT PLUC	40	LEAD FRESH WATER	3980	4800	No
Surface	ABANDONMENT PLUC	510	LEAD FRESH WATER	380	1580	No

<u>PERFORATIONS</u>	<u>Zone</u>	<u>Top</u>	<u>Btm</u>	<u>Date</u>	<u>Reason</u>	<u>Comments</u>
NIOBRARA		7178	7260	06/16/2006	PRODUCTION	
CODELL		7478	7488	11/10/1993	PRODUCTION	

**Comments:**