




Lat40°, Inc. 1635 Foxtrail Drive, Suite 325 Loveland, CO 970-776-3321

# WELL LOCATION CERTIFICATE

THIS MAP DOES NOT REPRESENT A BOUNDARY SURVEY

SECTION: 24  
TOWNSHIP: 3N  
RANGE: 66W

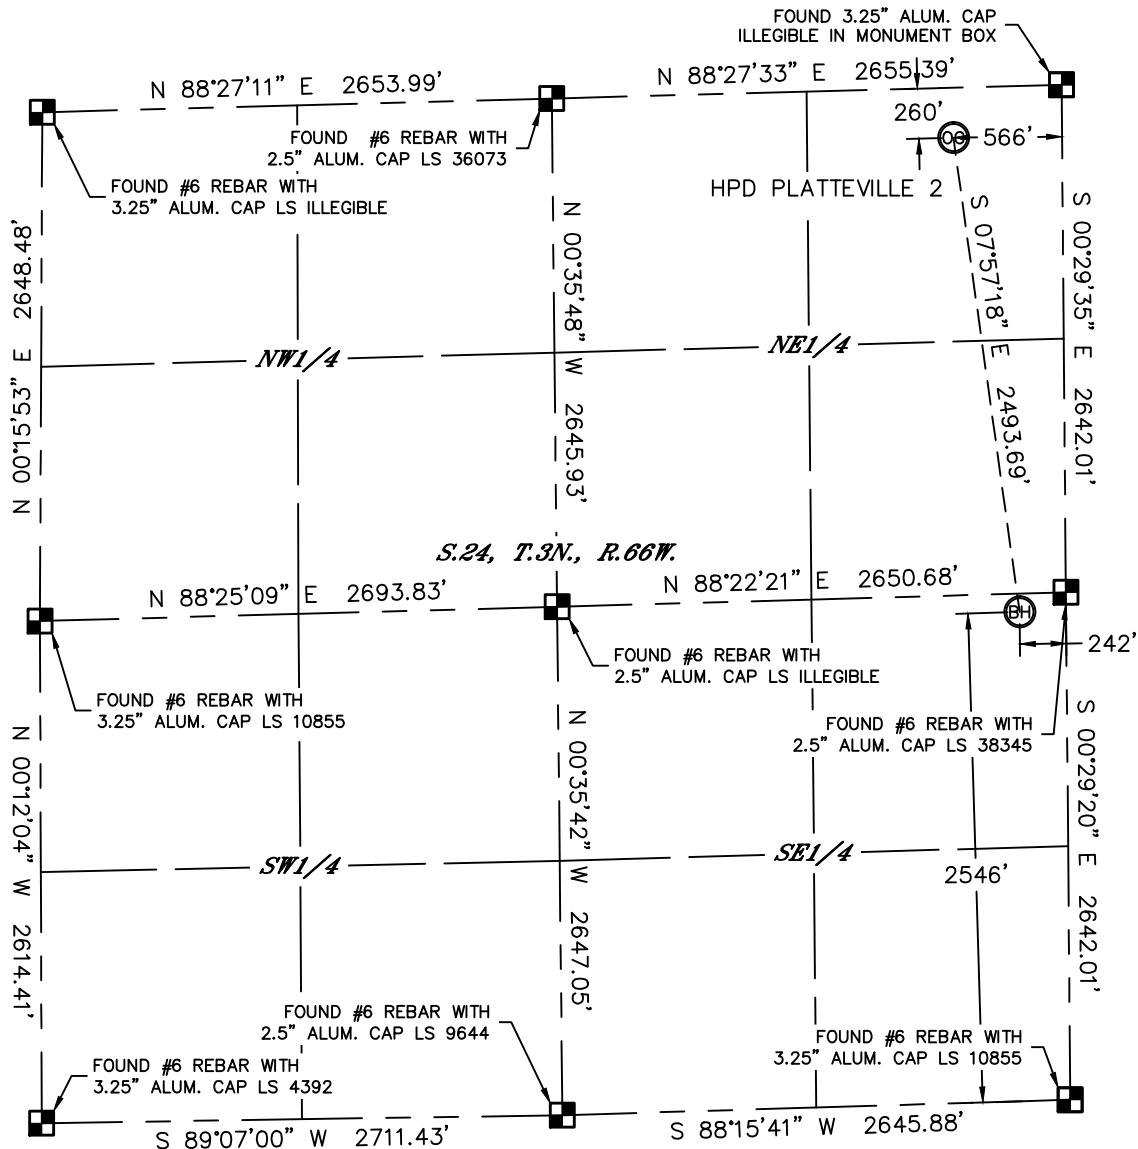

In accordance with a request from Derek Petrie with HIGH PLAINS DISPOSAL, INC. Lat40°, Inc. has determined the surface location of the HPD PLATTEVILLE 2 to be 260' from the NORTH line and 566' from the EAST line and the bottom hole to be 2546' from the SOUTH line and 242' from the EAST line as measured at right angles from the section lines of Section 24, Township 3 North, Range 66 West of the Sixth Principal Meridian, County of Weld, State of Colorado.

I hereby state that this Well Location Certificate was prepared by me, or under my direct supervision, that the fieldwork was completed on 4/9/2014, for and on behalf of HIGH PLAINS DISPOSAL, INC. That this is not a Land Survey Plat or an Improvement Survey Plat, and that it is not to be relied upon for establishment of fence, building, or other future improvement lines.

## SURFACE LOCATION

LAT: 40.21743°N  
LONG: 104.71778°W  
PDOP: 2.2  
ELEV: 5026'  
1/4,1/4: NENE

## BOTTOM HOLE


LAT: 40.21064°N  
LONG: 104.71662°W  
1/4,1/4: SENE

## NOTE:

- 1) Bearings shown are Grid Bearings of the Colorado State Plane Coordinate System, North Zone, North American Datum 1983/2007. The lineal dimensions as contained herein are based upon the "U.S. Survey Foot."
- 2) Ground elevations are based on an observed GPS elevation (NAVD 1988 DATUM).
- 3) IMPROVEMENTS: See LOCATION DRAWING for all visible improvements within 500' of disturbed area.
- 4) SURFACE USE: INDUSTRIAL
- 5) INSTRUMENT OPERATOR: BRIAN ROTTINGHAUS
- 6) NEAREST CULTURAL ITEMS:  
BUILDING: ±504' SW  
BUILDING UNIT: ±911' SW  
HIGH OCCUPANCY BUILDING UNIT: 5280'+  
DESIGNATED OUTSIDE ACTIVITY AREA: 5280'+  
PUBLIC ROAD: 253' N (COUNTY ROAD 32)  
ABOVEGROUND UTILITY: 234' E  
RAILROAD: 5280'+  
PROPERTY LINE: 210' E

## LEGEND

- = ALIQUOT MONUMENT AS DESCRIBED  
○ = CALCULATED POSITION

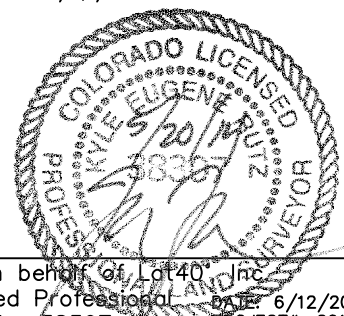

Kyle E. Rutz—On behalf of Lat40°, Inc.  
Colorado Licensed Professional Land Surveyor No. 38307  
DATE: 6/12/2014  
PROJECT#: 2014050