



## Schematic - Current

Well Name: McKee 21-21

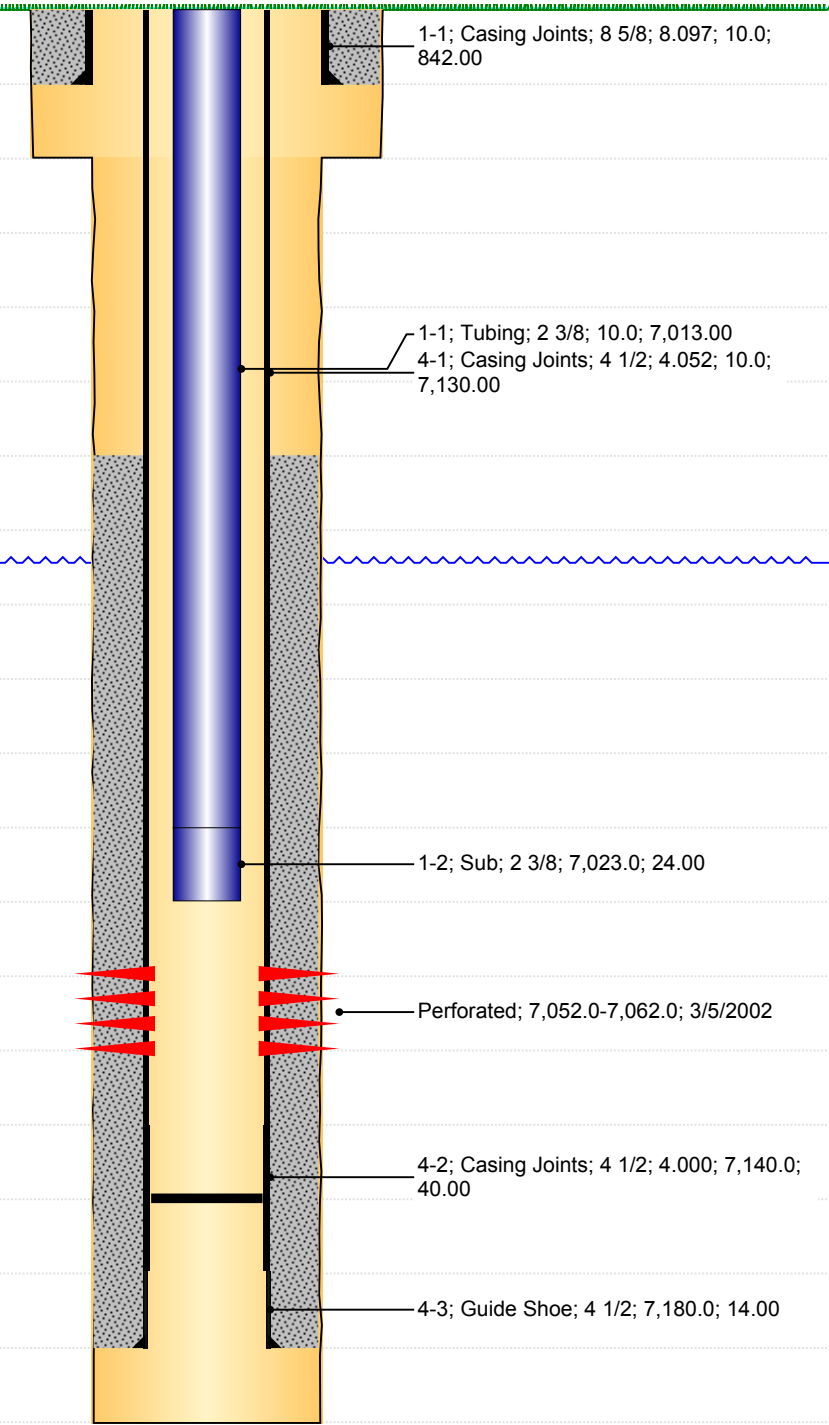
API 05123205160000	Surface Legal Location NENW 21 6N 64W	Field Name Wattenberg	State CO
Well Configuration Type Vertical	Ground Elevation (ft) 4,770.00	Original KB Elevation (ft) 4,780.00	KB-Ground Distance (ft) 10.00

### Most Recent Job

Job Category Completion/Workover	Primary Job Type Swab	Secondary Job Type	Start Date 5/13/2002	End Date 5/20/2002
-------------------------------------	--------------------------	--------------------	-------------------------	-----------------------

TD: 7,205.0

Vertical - Original Hole, 6/30/2014

MD (ftKB)	TVD (ftKB)	Incl (°)	DLS	Vertical schematic (actual)	Logs
9.8					
852.0					
859.9					
1,091.9					
2,500.0					
3,730.0				1-1; Tubing; 2 3/8; 10.0; 7,013.00 4-1; Casing Joints; 4 1/2; 4.052; 10.0; 7,130.00	
3,779.9					
3,830.1					
6,045.9					
6,056.1					
6,058.1					
7,023.0				1-2; Sub; 2 3/8; 7,023.0; 24.00	
7,046.9					
7,056.1					
7,062.0				Perforated; 7,052.0-7,062.0; 3/5/2002	
7,140.1					
7,168.0				4-2; Casing Joints; 4 1/2; 4.000; 7,140.0; 40.00	
7,180.1					
7,193.9				4-3; Guide Shoe; 4 1/2; 7,180.0; 14.00	
7,205.1					