Well Name: Wells Ranch 32-10

Vertical - Original Hole, 6/30/2014
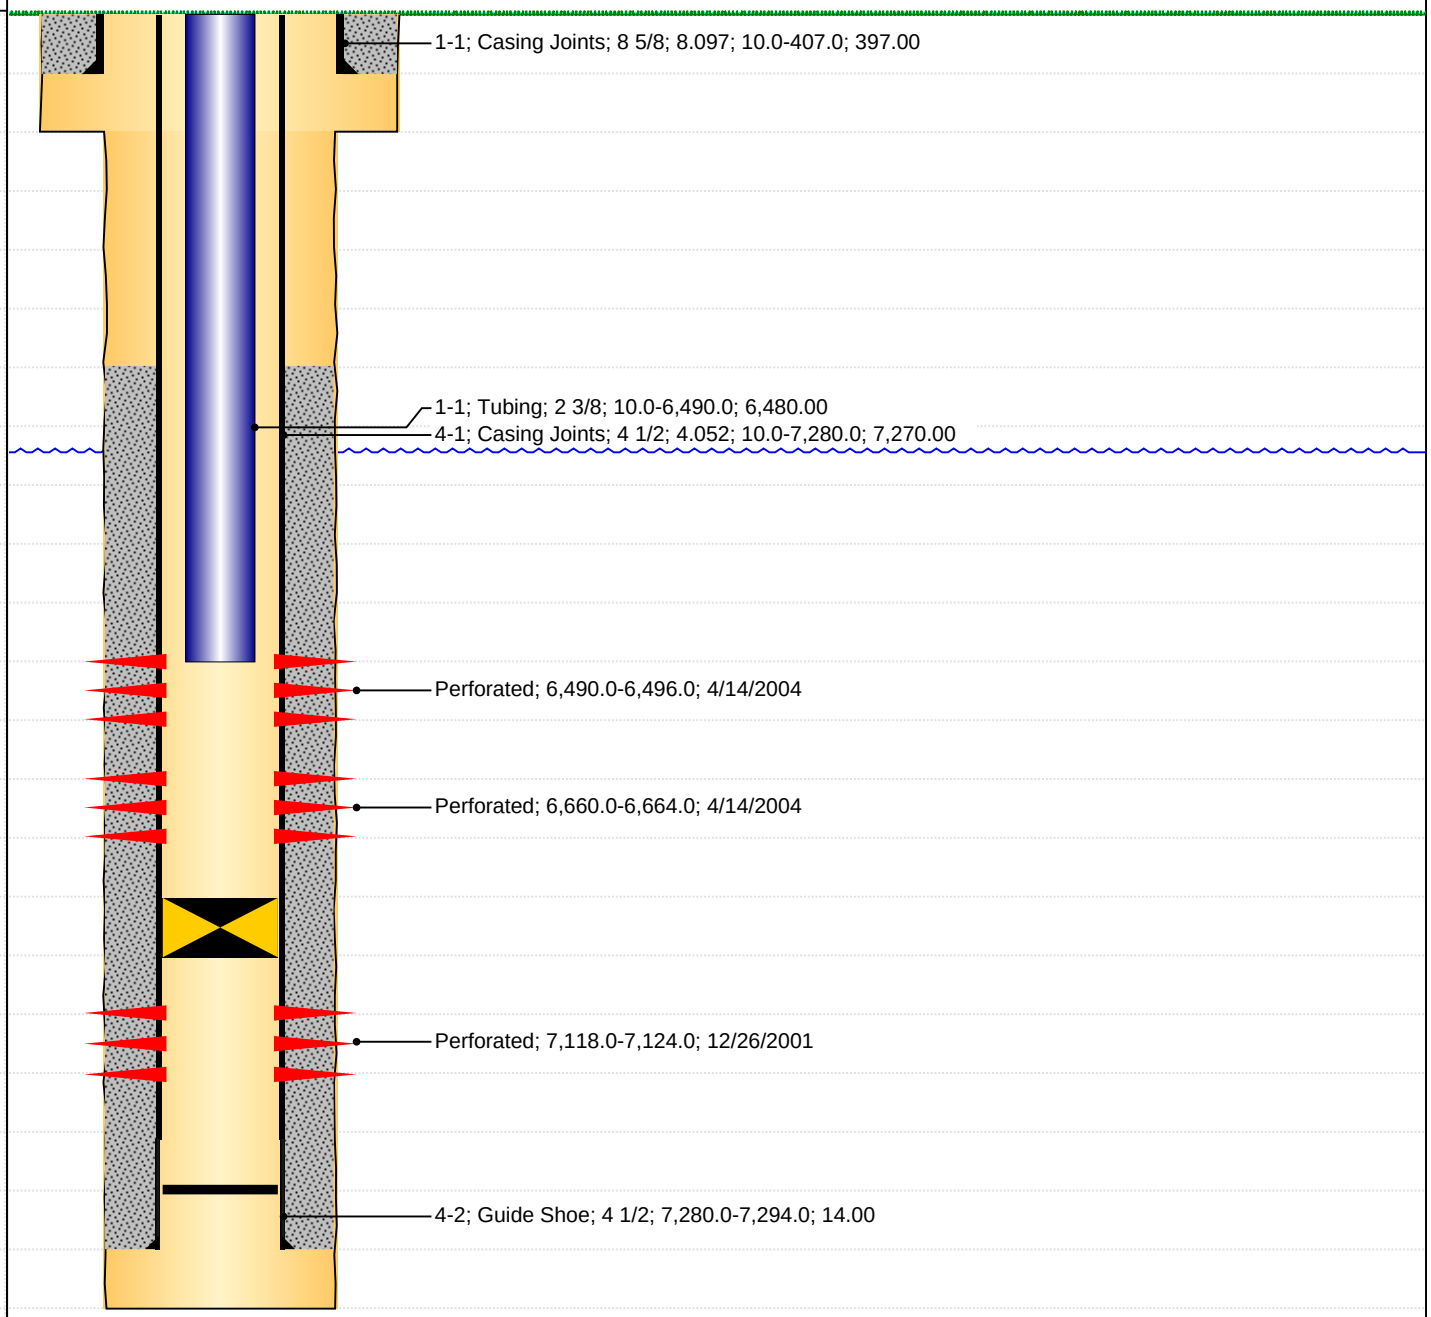
MD (ftKB)	TVD (ftKB)	Incl (°)	DLS DLS (°/100ft)	Vertical schematic (actual)
9.8				
407.2				
417.0				
657.2				
2,859.9				
3,060.0				
3,109.9				
3,160.1				
6,428.1				
6,438.0				
6,440.0				
6,490.2				
6,496.1				
6,660.1				
6,664.0				
7,109.9				
7,111.9				
7,118.1				
7,124.0				
7,279.9				
7,280.8				
7,294.0				
7,535.1