

## KERR-MCGEE OIL AND GAS ONSHORE LP

GIBLER 11-3A  
NE SW 3 2N 67W -- --  
WELD,COLORADO  
06/27/2014

AREA: W1

ROUTE: W13 Spud: 06/01/2000

WINS No.: 74792

AFE/WO#: 2098367

API#: 0512319965

GL: 4928

KB: 4940

MTD: 8070


TVD: 8070

LOG MD: 8075

PBMD: 8008

PBTVD: 8008

Directions: CR 19 & CR 24, E 3/10 TO HORSE CORAL, N&E 1/10 INTO(NEED TO MOVE IRON-PIPE FENCING PRIOR TO RIG ARRIVAL)

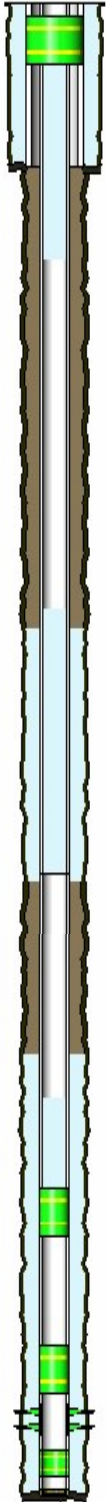

<u>HOLE SECTIONS</u>	<u>Size</u>	<u>Top</u>	<u>Btm</u>	<u>TD Date</u>
SURFACE	12.25	12	740	06/02/2000
PRODUCTION	7.88	740	8075	06/06/2000

<u>TUBULARS</u>	<u>Tool Type</u>	<u>Joints</u>	<u>Size</u>	<u>Weight</u>	<u>Grade</u>	<u>Thread</u>	<u>Top D</u>	<u>Bottom D</u>
SURFACE CASING	Casing	17	8.63	24			12	730
PRODUCTION CASING	Casing	118	4.50	11.6	I-80		12	5198
		1	4.50				5198	5202
	Casing	65	4.50	11.6	I-80		5202	8032
		1	4.50				8032	8034
	Casing	1	4.50	11.6	I-80		8034	8061
	Casing Guide Shoe	1	4.50				8061	8062
BRIDGE PLUG	Cast Iron Bridge Plu	1	4.50				7185	7187
BRIDGE PLUG	Cast Iron Bridge Plu	1	4.50				7885	7887
BRIDGE PLUG	Cast Iron Bridge Plu	1	8.63				80	83

<u>CEMENT JOBS</u>	<u>Stage</u>	<u>Sacks</u>	<u>Cement Jobs</u>	<u>Top D</u>	<u>Btm D</u>	<u>cbl</u>
SURFACE CASING	STAGE 1	515	NEAT	12	740	No
PRODUCTION CASING	STAGE 2	380	50/50 POZ-MIX	3653	5150	Yes
	STAGE 2 TAIL	50	G	5150	5248	Yes
	STAGE 1	330	G	6347	8062	Yes
PRODUCTION CASING	ABANDONMENT PLUC	30	LEAD FRESH WATER	6612	7185	No
PRODUCTION CASING	ABANDONMENT PLUC	95	LEAD FRESH WATER	3520	5200	No
PRODUCTION CASING	ABANDONMENT PLUC	275	LEAD FRESH WATER	90	1320	No

<u>PERFORATIONS</u>	<u>Formation</u>	<u>Zone</u>	<u>Top</u>	<u>Btm</u>	<u>Date</u>	<u>Reason</u>	<u>Comments</u>
	J SAND		7944	7968	06/26/2000	PRODUCTION	

Comments: