WELL NAME:	**West Crow Hill #14-26**	**COUNTY:**	Weld	**SPUD:**	6/3/98
OPERATOR:	Lyco Energy Corp	**STATE:**	Colorado	**P&A:**	6/10/98
COMP ZONE:	N/A	**API :**	05-123-19620	**GL:**	5,001'
LOCATION:	8N 61W S26 SW SW				

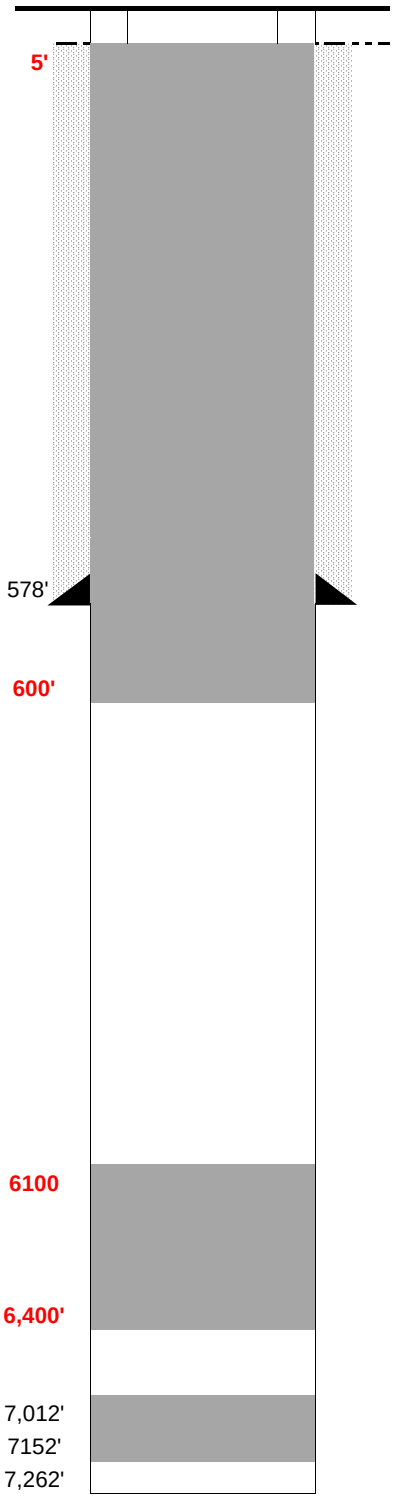

SURFACE CASING

DEPTH: 578' SIZE: 8.625" GRADE: WT (#/ft): 24.0

CEMENT: 200 sx

COMMENTS:

PRODUCTION CASING

DEPTH: SIZE: GRADE: WT (#/ft):

CEMENT: TOC:

COMMENTS:

PERFS: - PROD ZONE 1:

PERFS: - ZONE 2:

PERFS: - ZONE 3:

PREVIOUS PLUGS

RECOVERED: SIZE:

CMT 1:	7,152'	-	7,012'	COMMENT: 40 sx cement
CMT 2:	665'	-	490'	COMMENT: 50 sx cement
CMT 3:	35'	-	4'	COMMENT: 10 sx cement

PROPOSED: Plug #1: 300' cement plug from 6,400' to 6,100' (300' at top of Niobrara)

Plug #2: Cement plug from 600' to surface to isolate FW sands

FORMATIONS:

NIOBRARA:	6,400'
FORT HAYS	6,630'
CODELL	6,658'
D SAND	7,083'
D SILT	
J SAND	7,154'