


WEXPRO COMPANY
P.O. BOX 458
ROCK SPRINGS, WY 82902

MFS FED 8-1
NWNE 8-2S-103W
LEASE NO. C-8035
API 0510308276
RIO BLANCO, COLORADO

NOTE: THIS LEASE FALLS UNDER THE SITE &
SECURITY PLAN ESTABLISHED BY WEXPRO
COMPANY. THE PLAN CAN BE REVIEWED AT
THE WEXPRO OFFICE IN ROCK SPRINGS
WYOMING WEEKDAYS BETWEEN 7:00 AM
AND 5:00 PM

← NORTH →

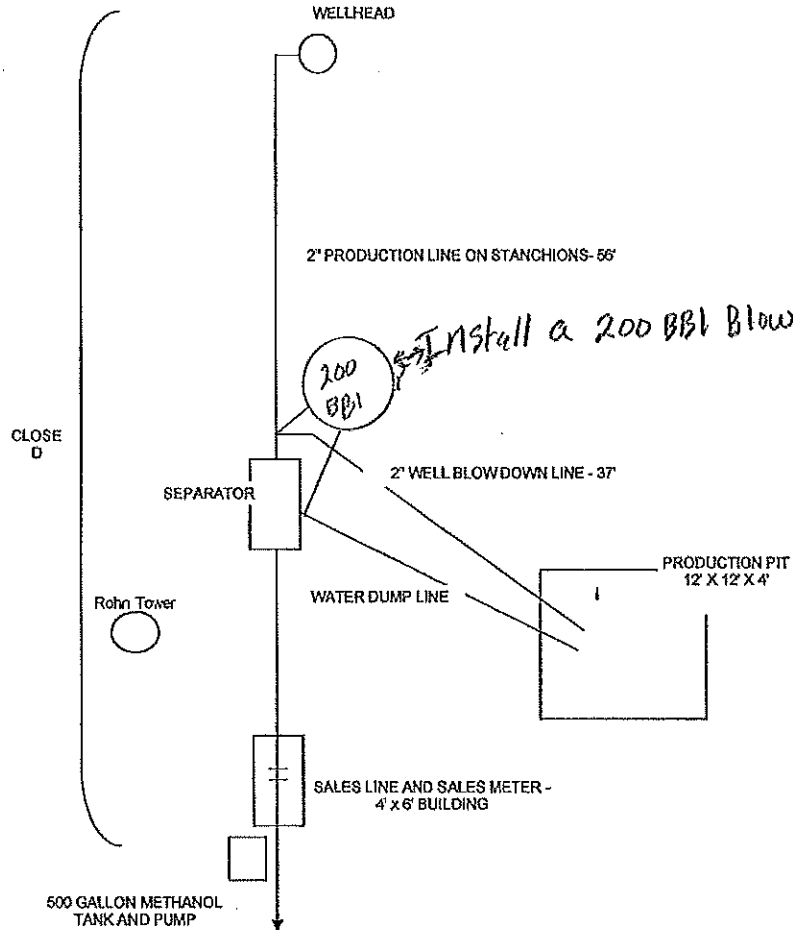

ACCESS ROAD

Date	Revision	By
6/3/2003	Added API# and Methanol Pump	
12/9/2009	Added Rohn Tower	