

Figure 1
 Site Location Map
 Rupert 1, 2, 32-9
 SE/4 S9 T4N R65W
 Weld County, Colorado

Drawn By: DBA
 Date: 03/31/2014





Scale: 1 inches equals 35 feet

DRAWN BY: CAW
 DATE: 3/5/2014

Facility Diagram
 PDC Energy, Inc.
 Rupert 1, 2, 32-9
 SE S9 T4N R65W
 Weld County, CO


 **TASMAN** GEOSCIENCES 6899 Pecos Street, Unit C
 Denver, CO 80221

LEGEND
 Approximate Area of Excavation
 Former Buried Produced Water Vessel
 DCP Gas Sales Line

FIGURE 2
 EXCAVATION
 SITE MAP



Agriculture

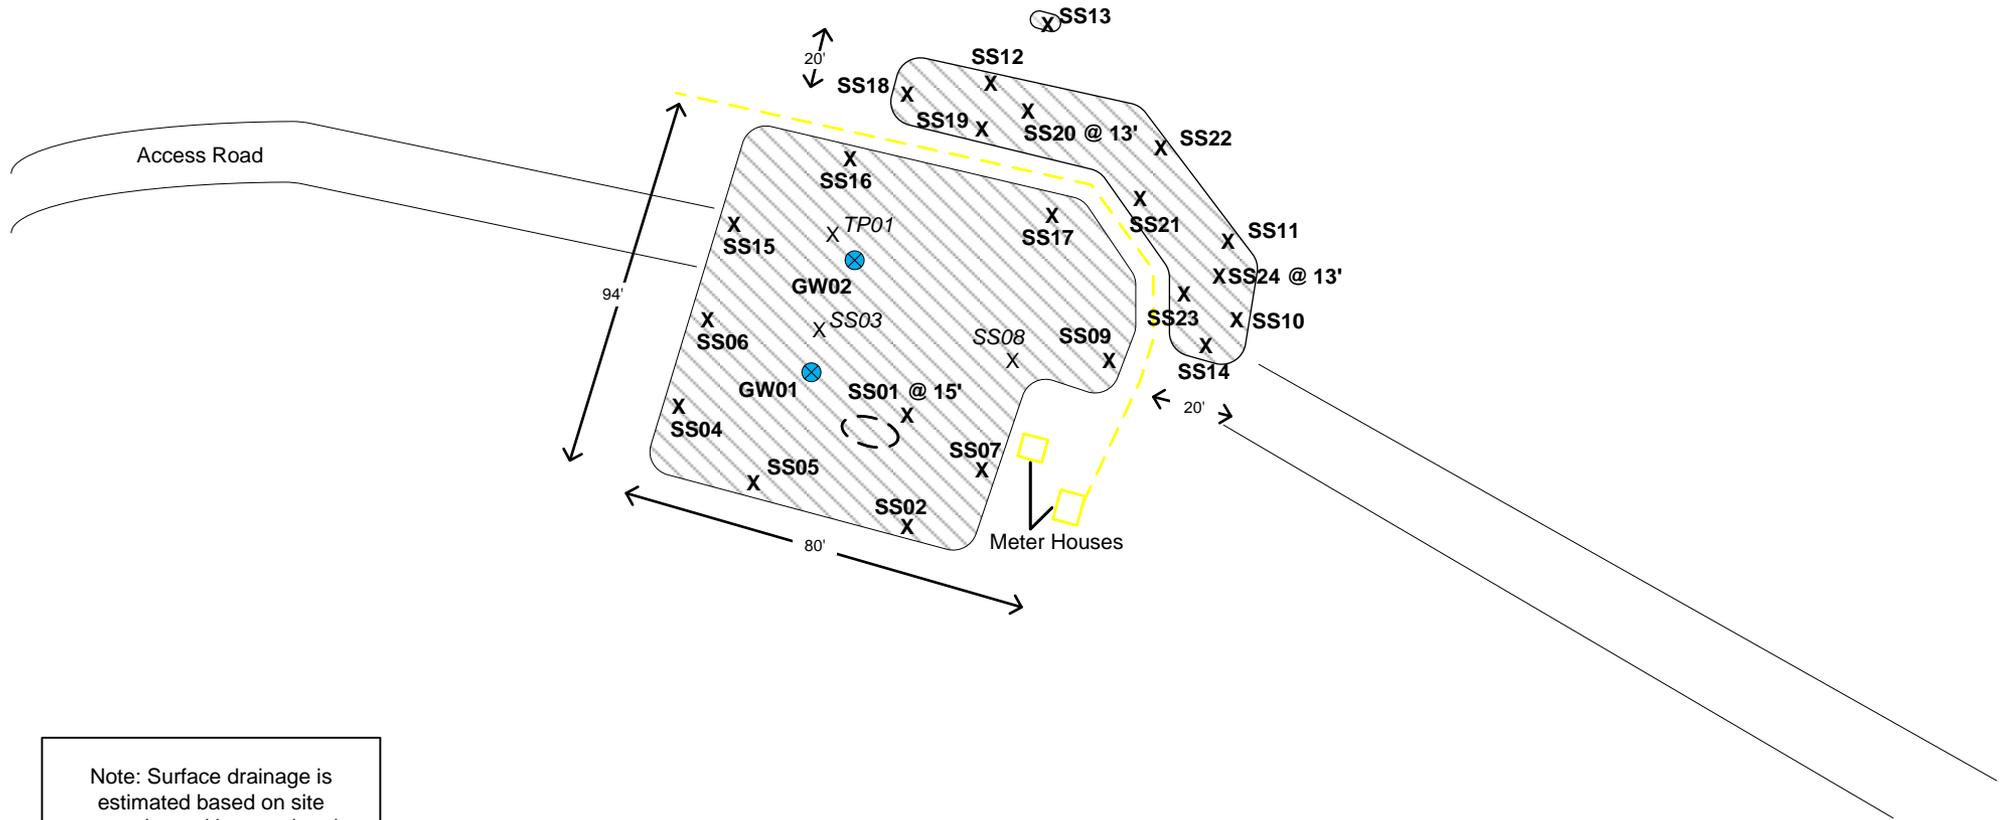

Scale: 1 inches equals 35 feet

DRAWN BY: CAW
DATE: 3/5/2014

Facility Diagram
PDC Energy, Inc.
Rupert 1, 2, 32-9
SE S9 T4N R65W
Weld County, CO



LEGEND	
	Approximate Area of Excavation
	Former Buried Produced Water Vessel
	DCP Gas Sales Line
	Soil Sample Location
	Soil Sample Location Subsequently Excavated
	Groundwater Sample Location

FIGURE 3
SAMPLE
LOCATION MAP