


**WELL NAME:** Dennis #F  
**OPERATOR:** Petroleum Energy Corp  
**COMP ZONE:** \_\_\_\_\_  
**LOCATION:** 9N 58W 33Sec SE NW 6 PM

**COUNTY:** Weld  
**STATE:** Colorado  
**API :** 05-123-14187

**SPUD:** 12/27/88  
**D&A:** 12/31/88  
**GL:** 4760'

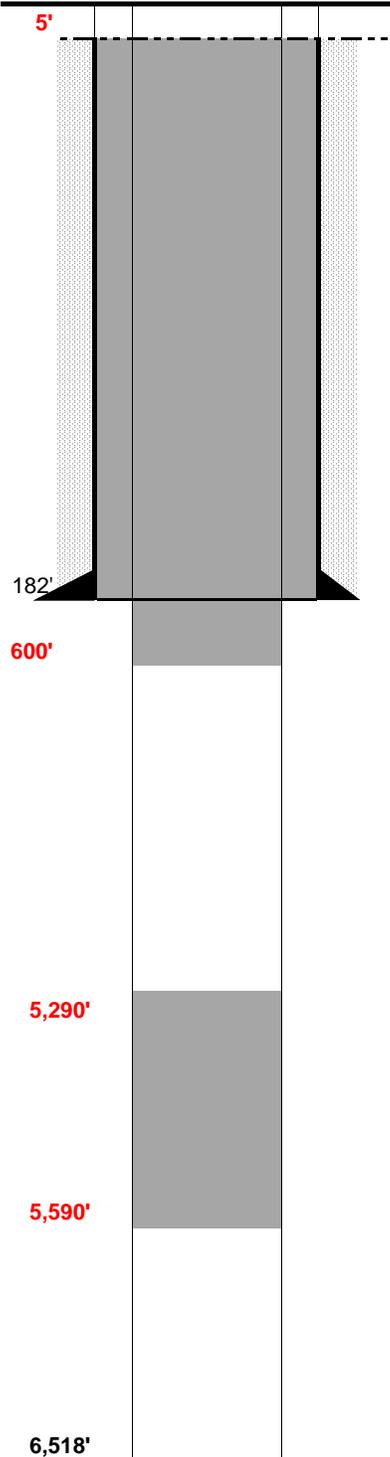

**SURFACE CASING**

DEPTH: 182' SIZE: 8.625" GRADE: \_\_\_\_\_ WT (#/ft): 24.0  
 CEMENT: \_\_\_\_\_  
 COMMENTS: \_\_\_\_\_

**PRODUCTION CASING**

DEPTH: \_\_\_\_\_ SIZE: \_\_\_\_\_ GRADE: \_\_\_\_\_ WT (#/ft): \_\_\_\_\_  
 CEMENT: \_\_\_\_\_ TOC: \_\_\_\_\_  
 COMMENTS: \_\_\_\_\_

PERFS: \_\_\_\_\_ - \_\_\_\_\_ PROD ZONE 1: \_\_\_\_\_  
 PERFS: \_\_\_\_\_ - \_\_\_\_\_ ZONE 2: \_\_\_\_\_  
 PERFS: \_\_\_\_\_ - \_\_\_\_\_ ZONE 3: \_\_\_\_\_

**PREVIOUS PLUGS**

RECOVERED: \_\_\_\_\_ SIZE: \_\_\_\_\_  
 CMT 1: 205' - 155' COMMENT: 25 SX  
 CMT 2: 30' - 4' COMMENT: 10 sx to surface  
 CMT 3: \_\_\_\_\_ - \_\_\_\_\_ COMMENT: \_\_\_\_\_  
 CMT 3: \_\_\_\_\_ - \_\_\_\_\_ COMMENT: \_\_\_\_\_

OTHER: Proposed Plug 1: 300' cement from 5590' to 5290' (above Niobrara)  
Proposed Plug #2: 600' cement from 600' to surface (Isolate FW Zones)

**FORMATIONS:**

FW Zone: \_\_\_\_\_  
 NIOBRARA: 5,590'  
 FORT HAYS 5,784'  
 CODELL 5,828'  
 D SAND 6,358'  
 J SAND 6,446'