


WELL LOCATION FOR AUGUSTUS ENERGY RESOURCES LLC

DUSTY FARMS 42-13 5N47W

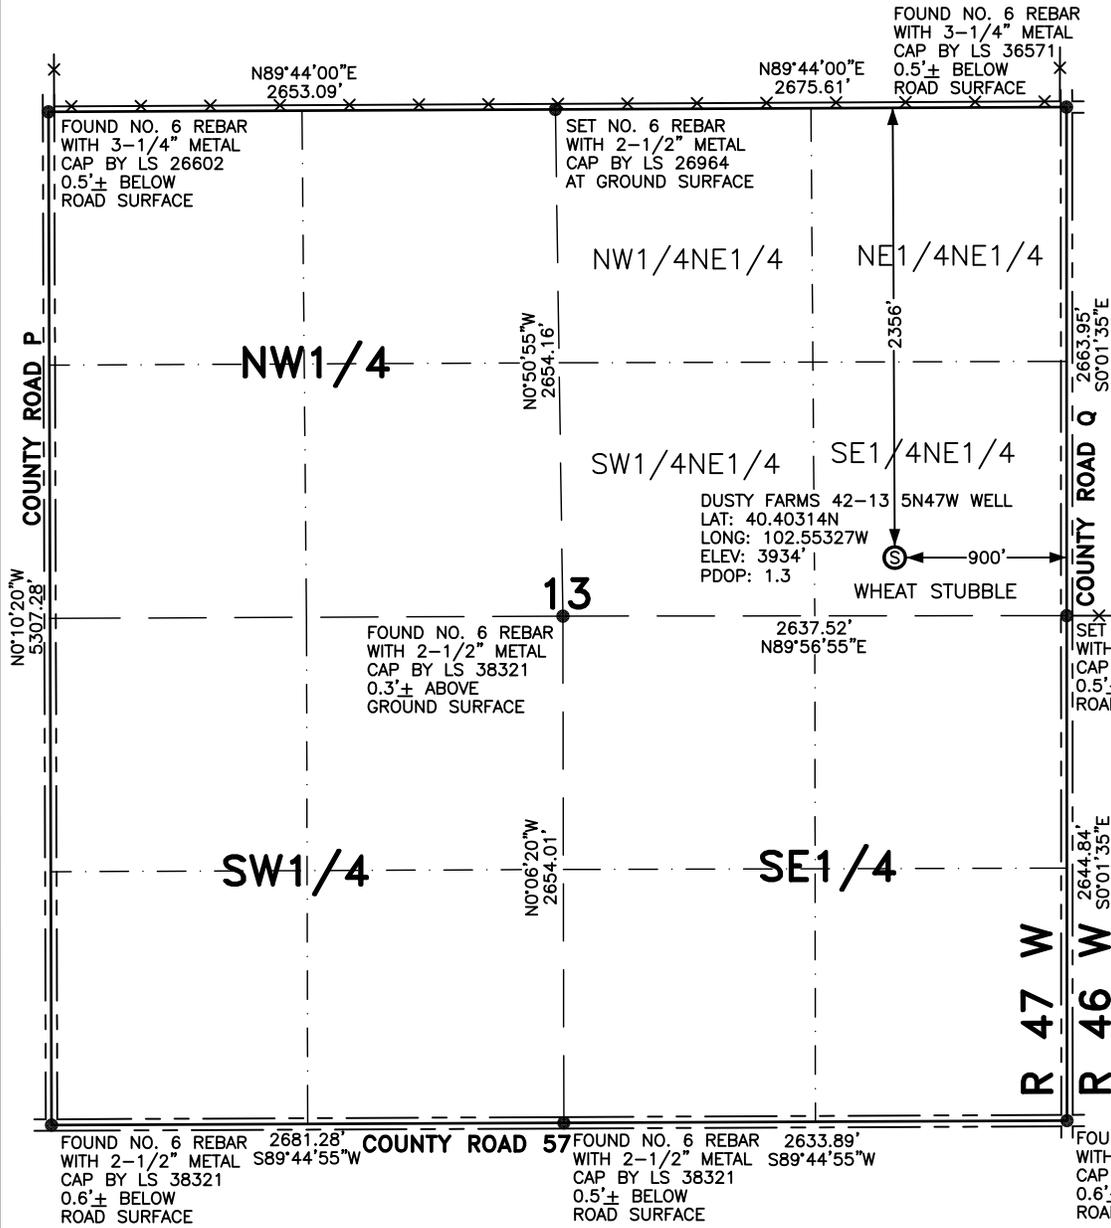

NOTES

BEARINGS SHOWN HEREON ARE BASED UPON RTK GPS OBSERVATIONS

SEE LOCATION DRAWING FOR IMPROVEMENTS WITHIN 700' OF LOCATION.

USGS QUAD MAP: CLARKEVILLE NE, COLO.


LAT/LONG VALUES ARE NAD83

ELEVATIONS BASED UPON NGS OPUS SOLUTION NAVD 88 DATUM

ALL DISTANCES TO SECTION LINES ARE MEASURED PERPENDICULAR TO AND ARE AT RIGHT ANGLES TO SAID SECTION LINES.

LEGEND

- ⊙ FIELD SURVEYED WELL LOCATION
- == == == ROAD
- x-x- FENCE

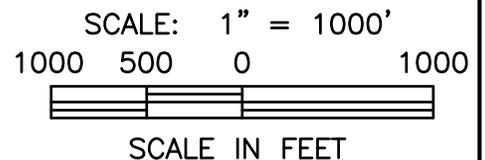

THIS WELL LOCATION PLAT HAS BEEN PREPARED FOR AUGUSTUS ENERGY RESOURCES LLC TO LOCATE THE DUSTY FARMS 42-13 5N47W WELL BEING 900 FEET FROM THE EAST LINE AND 2356 FEET FROM THE NORTH LINE IN THE SE1/4NE1/4 OF SECTION 13, TOWNSHIP 5 NORTH, RANGE 47 WEST OF THE 6TH P.M., YUMA COUNTY, COLORADO. THE SURFACE ELEVATION AT THIS POINT IS 3934 FEET. THIS IS NOT A LAND SURVEY PLAT.



LEIBERT-McATEE & ASSOCIATES, INC.

P.O. BOX 442 615 SOUTH TENTH AVENUE
 STERLING, CO 80751 970-522-1960

FIELD DATE: 6-24-14	DWG DATE: 6-27-14	GPS OPERATOR: DARREN VEAL
DUSTY FARMS 42-13 5N47W	DWG NO. 852-14	SHEET 1 OF 1