

KERR-MCGEE OIL AND GAS ONSHORE LP

NESG 39-23

SW SW 24 3N 68W 1,185' FSL 882' FWL

WELD,COLORADO

06/27/2014

AREA: W2

ROUTE: W22 Spud: 03/01/2008

WINS No.: 93285

AFE/WO#: 88481203

API#: 0512324979

GL: 4950

KB: 4970

MTD: 7590


TVD: 7481

LOG MD: 7598

PBMD: 7547

PBTVD: 7438

Directions: HWY 66 & WCR 11, 1/10 E, N INTO

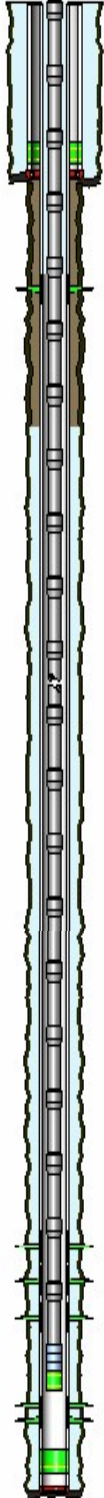

<u>HOLE SECTIONS</u>	<u>Size</u>	<u>Top</u>	<u>Btm</u>	<u>TD Date</u>					
SURFACE	12.25	20	921	03/01/2008					
PRODUCTION	6.50	921	7590	03/06/2008					
<u>TUBULARS</u>	<u>Tool Type</u>	<u>Joints</u>	<u>Size</u>	<u>Weight</u>	<u>Grade</u>	<u>Thread</u>	<u>Top D</u>	<u>Bottom D</u>	
SURFACE CASING	Casing	19	8.63	24.00	J-55	STC	20	868	
	Baffle	1	8.63				868	868	
	Casing	1	8.63	24.00	J-55	STC	868	912	
	Casing Guide Shoe	1	9.00				912	913	
PRODUCTION CASING	Casing	172	4.50	11.60	I-80	LTC	20	7547	
	Latch Down Baffle	1	4.50				7547	7547	
	Casing	1	4.50	11.60	I-80	LTC	7547	7575	
	Casing Float Shoe	1	4.50				7575	7577	
PRODUCTION TUBING	Tubing	234	2.38	4.70	J-55	External-Ups	0	7401	
	Seating Nipple	1					7401	7402	
	Notched Collar	1					7402	7402	
<u>CEMENT JOBS</u>	<u>Stage</u>	<u>Sacks</u>	<u>Cement Jobs</u>				<u>Top D</u>	<u>Btm D</u>	<u>cbl</u>
SURFACE CASING	PRIM CMT 1ST STAGE	330	LEAD	50/50 POZ-MIX			20	700	No
	PRIM CMT 1ST STAGE	100	TAIL	TYPE 2			700	921	No
PRODUCTION CASING	PRIM CMT 1ST STAGE	159	LEAD	50/50 POZ-MIX			2350	5140	Yes
	PRIM CMT 1ST STAGE	50	MIDDLE	HLC EXTREME LITE			5750	5830	Yes
	PRIM CMT 1ST STAGE	82	TAIL	HLC			6275	7598	Yes
PRODUCTION CASING	ABANDONMENT PLUC	210	LEAD	FRESH WATER			0	1500	No
<u>PERFORATIONS</u>									
<u>Formation</u>	<u>Zone</u>	<u>Top</u>	<u>Btm</u>	<u>Date</u>	<u>Reason</u>	<u>Comments</u>			
		1500	1501	04/26/2014	CEMENT SQUEEZE				
NIOBRARA		7184	7198	04/14/2008	PRODUCTION	A Bench			
NIOBRARA		7234	7248	04/14/2008	PRODUCTION	B Bench			
NIOBRARA		7300	7320	04/14/2008	PRODUCTION	C Bench			
CODELL		7440	7460	04/11/2008	PRODUCTION				

Comments: