

KERR-MCGEE OIL AND GAS ONSHORE LP

UPRR 41 PAN AM H 1

NE SE 23 3N 68W 1,345' FSL 1,305' FEL

WELD,COLORADO

06/23/2014

AREA: W2

ROUTE: W22 Spud: 12/04/1989

WINS No.: 74291

AFE/WO#: 88497216

API#: 0512314386

GL: 4975

KB: 4988

MTD: 7985


TVD: 7985

LOG MD: 7977

PBMD: 7891

PBTVD: 7891

Directions: HWY 66 & WCR 9-1/2, N 1/4, E 1/4 INTO

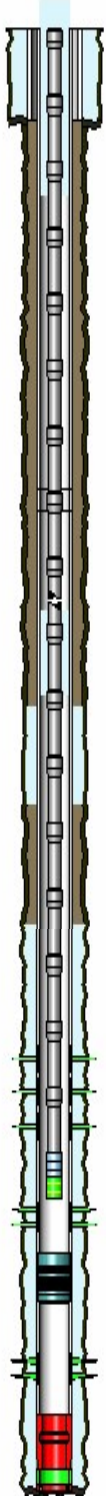

<u>HOLE SECTIONS</u>		<u>Size</u>	<u>Top</u>	<u>Btm</u>	<u>TD Date</u>			
SURFACE		12.25	13	680	12/04/1989			
PRODUCTION		7.88	680	7985	12/10/1989			
<u>TUBULARS</u>		<u>Tool Type</u>	<u>Joints</u>	<u>Size</u>	<u>Weight</u>	<u>Grade</u>	<u>Thread</u>	<u>Top D</u> <u>Bottom D</u>
SURFACE CASING		Casing	15	8.63	24	J-55	STC	13 667
PRODUCTION CASING		Casing	72	5.50	17.00	N-80	BT&C	13 3254
		Crossover	1	5.50		N-80		3254 3299
		Casing	109	5.50	17.00	N-80	LT&C	3299 7934
		Float Collar	1	5.50				7934 7936
		Shoe Joint	1	5.50	17.00	N-80	LT&C	7936 7979
		Casing Shoe	1	5.50				7979 7980
BRIDGE PLUG		Bridge Plug	1	5.50				7490 7493
PRODUCTION TUBING		Tubing	236	2.38	4.70	J-55	8RD EUE	13 7290
		Seating Nipple	1					7290 7291
		Notched Collar	1					7291 7291
<u>CEMENT JOBS</u>		<u>Stage</u>	<u>Sacks</u>	<u>Cement Jobs</u>		<u>Top D</u>	<u>Btm D</u>	<u>cbl</u>
SURFACE CASING		STAGE 1	225	LEAD	WRC LITE	13	400	No
		STAGE 1	100	TAIL	REGULAR	400	667	No
PRODUCTION CASING		STAGE 1	400		G	6240	7980	Yes
PRODUCTION CASING		REMEDIAL CEMENT	270	LEAD	FRESH WATER	4676	5375	No
PRODUCTION CASING		ABANDONMENT PLUC	120	LEAD	FRESH WATER	4000	4610	No
PRODUCTION CASING		ABANDONMENT PLUC	130	LEAD	FRESH WATER	0	1200	No
<u>PERFORATIONS</u>		<u>Formation</u>	<u>Zone</u>	<u>Top</u>	<u>Btm</u>	<u>Date</u>	<u>Reason</u>	<u>Comments</u>
				1200	1201	05/23/2014	CEMENT SQUEEZE	
				4610	4611	05/27/2014	CEMENT SQUEEZE	
				5375	5376	05/22/2014	CHEMICAL INJECTION	
NIOBRARA		A		7092	7098	03/01/2012	PRODUCTION	
NIOBRARA		B		7132	7136	03/01/2012	PRODUCTION	
NIOBRARA		C		7188	7202	03/01/2012	PRODUCTION	
CODELL				7324	7344	03/01/2012	PRODUCTION	
J SAND				7766	7810	05/24/1990	PRODUCTION	VANN GUN SYSTEM

Comments: