

# FINAL ABANDONMENT WELLBORE DIAGRAM

NATTIE 1


Pronghorn Operating LLC (#10422)

SESE, Sec. 6-14S-44W 6PM

API #: 05-017-07751

Cheyenne Cty, CO

13 3/8" 24# @ 464'

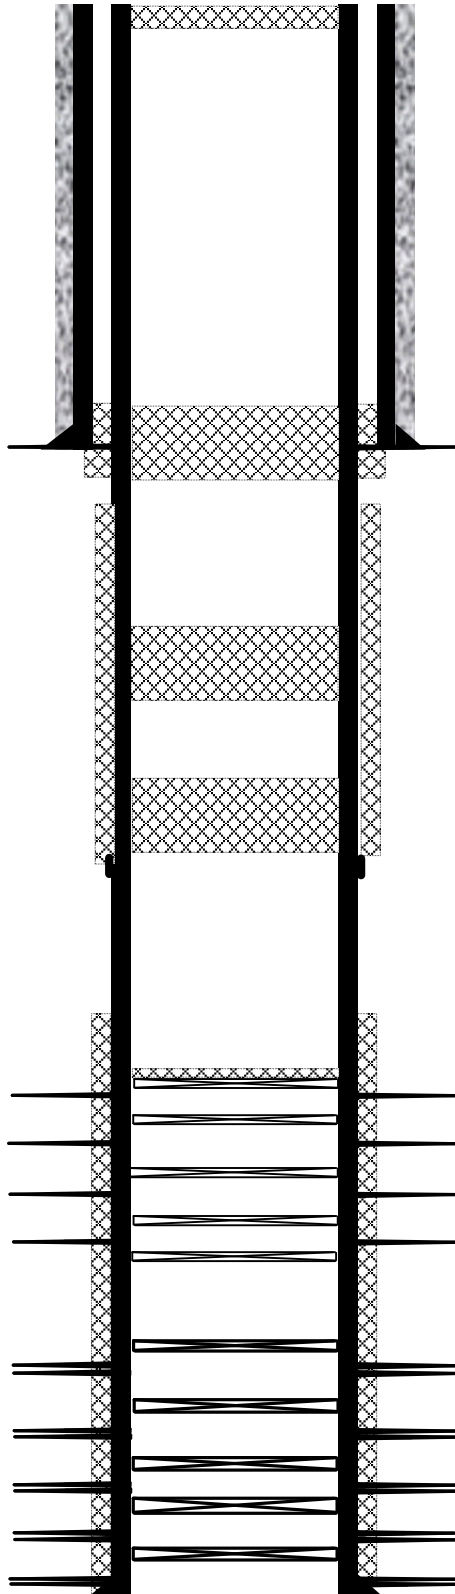

40sx at surface

Perfs @ 500-501', squeezed 90 sx 400'-500' in casing annulus, layed 20sx 400-500' insude casing

TOC @ 950'

(CBL)

20 sx 1625' - 1800'

20 sx 2225' - 2400'

2500' Stage Tool, 250sx

TOC @ 3876'

(CBL)

4130'	CIBP w 2 sx
4148' - 4154'	Perfs
4161'	CIBP
4165' - 4168'	Perfs
4185'	CIBP
4196'-4198'	Perfs
4199'	CIBP
4200'-4208'	Perfs
4210'-4211'	Squeeze Holes, 100sx OWC
4800'	CIBP w 2sx
4812'-4816'	Perfs
5385'	CIPB w 2 sx
5401'-5406'	perfs
5448'	CIPB w 2 sx
5456'-5460'	perfs
5500'	CIBP w 2 sx
5606'-5510'	perfs
5535'	CIBP w 2 sx
5545'-5549'	perfs

5613' 5 1/2", 15.5# Production Casing