


**WPX Energy Rocky Mountain LLC
 WPX ENERGY PA 424-2
 Parachute Field**

**SHL 2008' FSL 1571' FWL (NE/4 SW/4) Section 2 T7S R95W 6th PM
 BHL 537' FSL 1922' FWL (SE/4 SW/4) Section 2 T7S R95W 6th PM
 Garfield County Colorado**

**Formation Tops
 (Measured Depths)**

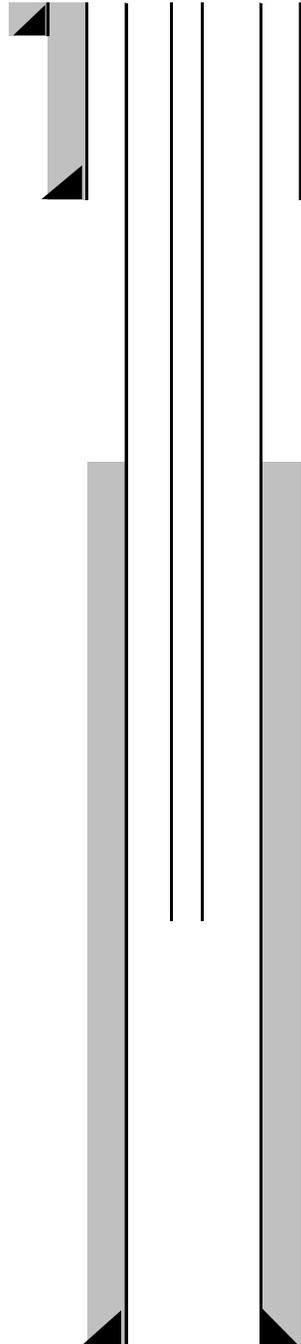

Conductor 26" Hole 18" casing/liner 63' W/ 24 Sks cmt

Cmt @ Surface - (Cmt circ to surf during cmt job)

**9-5/8" 32.3 ppf Csg. Set @ 990'
 In 13-1/2" Hole W/ 270 Sks. Cmt**

Top Of Cement @ 2870'

"G" Sand @ 1977'

Mesaverde @ 4260'

Cameo @ 6636'

Rollins @ 7579'

Tubing String: 2-3/8" Set @ 7294'

**5550-5831' Mesaverde
 5890-6112' Mesaverde
 6209-6395' Mesaverde
 6446-6676' Mesaverde
 6770-7068' Mesaverde/Cameo
 7200-7480' Cameo**

**PBTD @ 7710'
 TMD @ 7760'
 TVD @ 7488'**

4-1/2", 11.6 ppf. Csg. Set @ 7742' W/ 1450 Sks Cmt

DATE CREATED: 6/23/2014

**NOTE: THIS IS NOT TO SCALE.
 FINAL**