


DIAGRAM OF VISIBLE IMPROVEMENTS McCall 33-09

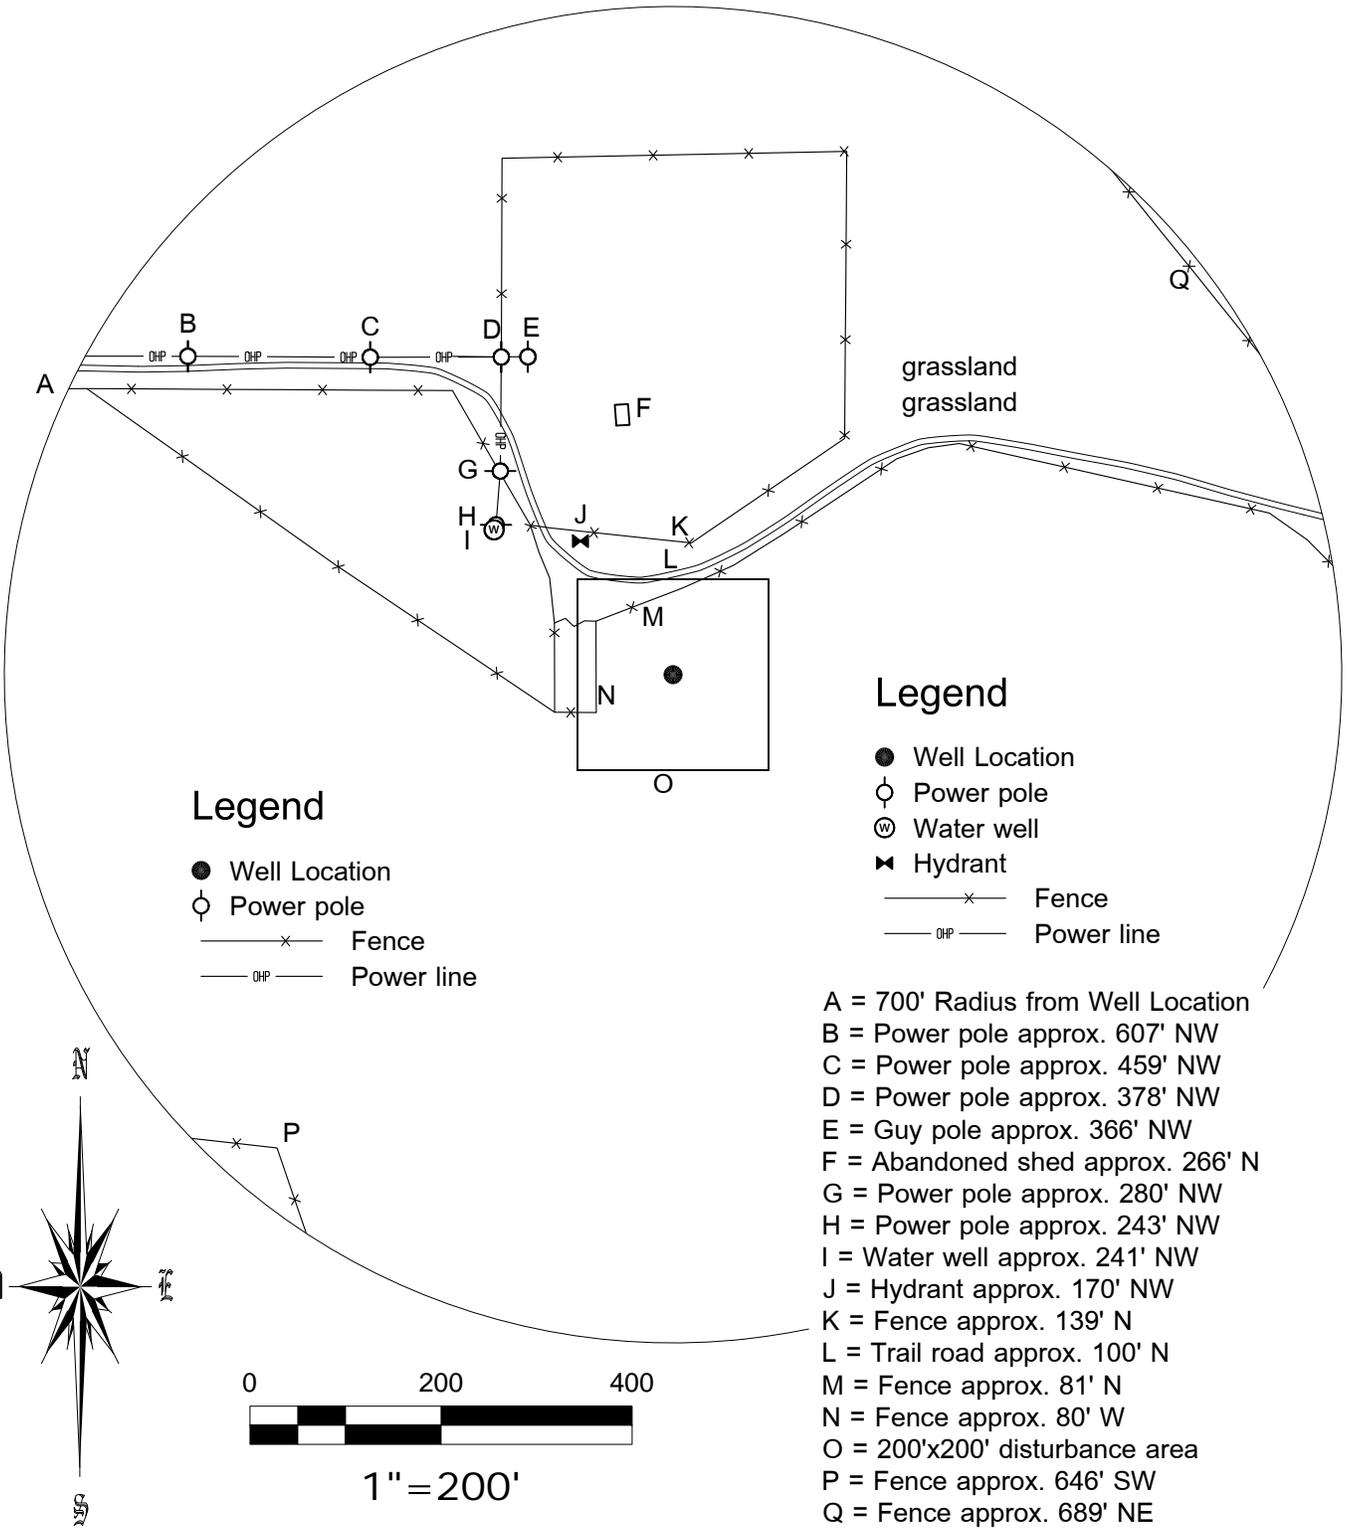



Legend

- Well Location
- Power pole
- x— Fence
- DHP— Power line

Legend

- Well Location
- Power pole
- ⊗ Water well
- ▶ Hydrant
- x— Fence
- DHP— Power line

- A = 700' Radius from Well Location
- B = Power pole approx. 607' NW
- C = Power pole approx. 459' NW
- D = Power pole approx. 378' NW
- E = Guy pole approx. 366' NW
- F = Abandoned shed approx. 266' N
- G = Power pole approx. 280' NW
- H = Power pole approx. 243' NW
- I = Water well approx. 241' NW
- J = Hydrant approx. 170' NW
- K = Fence approx. 139' N
- L = Trail road approx. 100' N
- M = Fence approx. 81' N
- N = Fence approx. 80' W
- O = 200'x200' disturbance area
- P = Fence approx. 646' SW
- Q = Fence approx. 689' NE

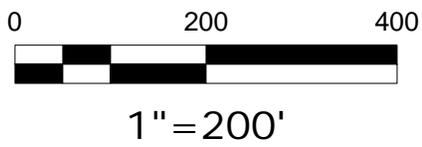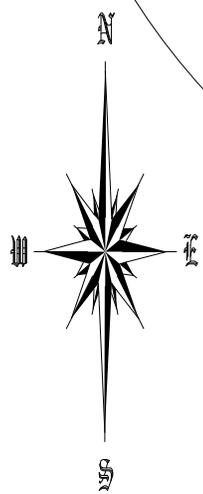

FORTY NORTH, LLC
LAND SURVEYING
 53575 County Road NN
 Wray, CO 80758
 (970) 466-0552
 fortynorthllc@gmail.com

DATE OF FIELD WORK 6/25/2014	DATE OF DRAWING 6/28/2014	PROJECT NO. 1083.026
Augustus Energy Resources, LLC McCall 33-09 1N46W		
NW1/4 SE1/4 SEC. 9, T1N, R46W, 6PM, Yuma County, Colo.		