

KERR-MCGEE OIL AND GAS ONSHORE LP

ELLIOTT, KARL UNIT #1

-- -- 18 3N 67W 1,580' FNL 1,390' FEL


WELD, COLORADO

07/07/2014

AREA: ROUTE: Spud: 06/20/1974 WINS No.: H8023 AFE/WO#: 2097852 API#: 0512308066

GL: 4841 KB: 4851 MTD: 7745 TVD: 7745 LOG MD: 7752 PBMD: 7710 PBTVD: 7710

Directions: CR 34 & CR 15, S 5/10, W 2/10, N 1/10 INTO.

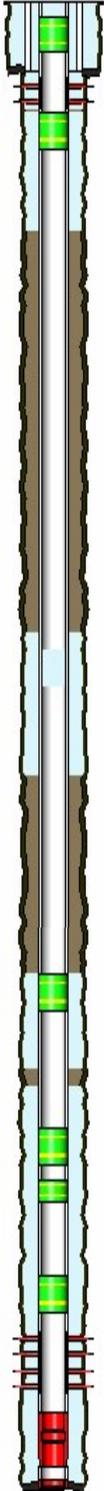

<u>HOLE SECTIONS</u>		<u>Size</u>	<u>Top</u>	<u>Btm</u>	<u>TD Date</u>				
SURFACE		12.25	10	213	06/20/1974				
PRODUCTION		7.88	213	7752	06/27/1974				
<u>TUBULARS</u>		<u>Tool Type</u>	<u>Joints</u>	<u>Size</u>	<u>Weight</u>	<u>Grade</u>	<u>Thread</u>	<u>Top D</u>	<u>Bottom D</u>
SURFACE CASING		Casing		8.63	20.00			10	213
PRODUCTION CASING		Casing		4.50	10.50	K-55	ST&C	10	7710
		Casing Float Collar		4.50				7710	7710
		Casing		4.50	11.60	K-55	ST&C	7710	7749
		Casing Guide Shoe	1	4.50				7749	7750
BRIDGE PLUG		Cast Iron Bridge Plu	1	4.50				7500	7501
CAST IRON CEMENT RETAINER		Cement Retainer	1	4.50				6963	6967
BRIDGE PLUG		Cement Retainer	1	4.50				6130	6132
BRIDGE PLUG		Cast Iron Bridge Plu	1	4.50				6975	6977
BRIDGE PLUG		Cast Iron Bridge Plu	1	4.50				80	82
BRIDGE PLUG		Cement Retainer	1	4.50				290	292
<u>CEMENT JOBS</u>		<u>Stage</u>	<u>Sacks</u>	<u>Cement Jobs</u>		<u>Top D</u>	<u>Btm D</u>	<u>chl</u>	
SURFACE CASING		PRIM CMT 1ST STAGE	200	REGULAR		10	213	No	
PRODUCTION CASING		PRIM CMT 1ST STAGE	200	50/50 POZ-MIX		6910	7750	Yes	
PRODUCTION CASING		REMEDIAL CEMENT	400	50/50 POZ-MIX		3720	4720	Yes	
		REMEDIAL CEMENT	80	50/50 POZ-MIX		6660	6910	Yes	
PRODUCTION CASING		SQUEEZE JOB	70	REGULAR		86	270	No	
--None--		TOP OUT JOB	50	REGULAR		12	86	No	
PRODUCTION CASING		SQUEEZE JOB	150	LEAD	FRESH WATER	6120	6540	No	
PRODUCTION CASING		ABANDONMENT PLUC	20	LEAD	FRESH WATER	3842	4100	No	
PRODUCTION CASING		SQUEEZE JOB	360	LEAD	FRESH WATER	280	880	No	
<u>PERFORATIONS</u>		<u>Formation</u>	<u>Zone</u>	<u>Top</u>	<u>Btm</u>	<u>Date</u>	<u>Reason</u>	<u>Comments</u>	
				265	266	04/13/1995	CEMENT SQUEEZE		
				280	282	06/24/2014	CEMENT SQUEEZE		
				880	881	06/24/2014	CEMENT SQUEEZE		
NIOBRARA				6120	6122	06/23/2014	CEMENT SQUEEZE		
NIOBRARA				6540	6541	06/23/2014	CEMENT SQUEEZE		
J SAND				7600	7606	07/15/1974	PRODUCTION	Below abn plugs	
J SAND				7616	7627	07/15/1974	PRODUCTION		

KERR-MCGEE OIL AND GAS ONSHORE LP

ELLIOTT, KARL UNIT #1

-- -- 18 3N 67W 1,580' FNL 1,390' FEL

WELD,COLORADO

07/07/2014

AREA: ROUTE: Spud: 06/20/1974 WINS No.: H8023 AFE/WO#: 2097852 API#: 0512308066

GL: 4841 KB: 4851 MTD: 7745 TVD: 7745 LOG MD: 7752 PBMD: 7710 PBTVD: 7710

Directions: CR 34 & CR 15, S 5/10, W 2/10, N 1/10 INTO.

Comments: