

WPX Energy Rocky Mountain LLC

FEDERAL NER 434-32


RULISON Field

SHL 168' FNL 2598' FWL (SE/4 NW/4) Section 5 T7S R93W 6th PM

BHL 359' FSL 1779' FEL (SW/4 SE/4) Section 32 T6S R93W 6th PM

Garfield County Colorado

Formation Tops
(Measured Depths)

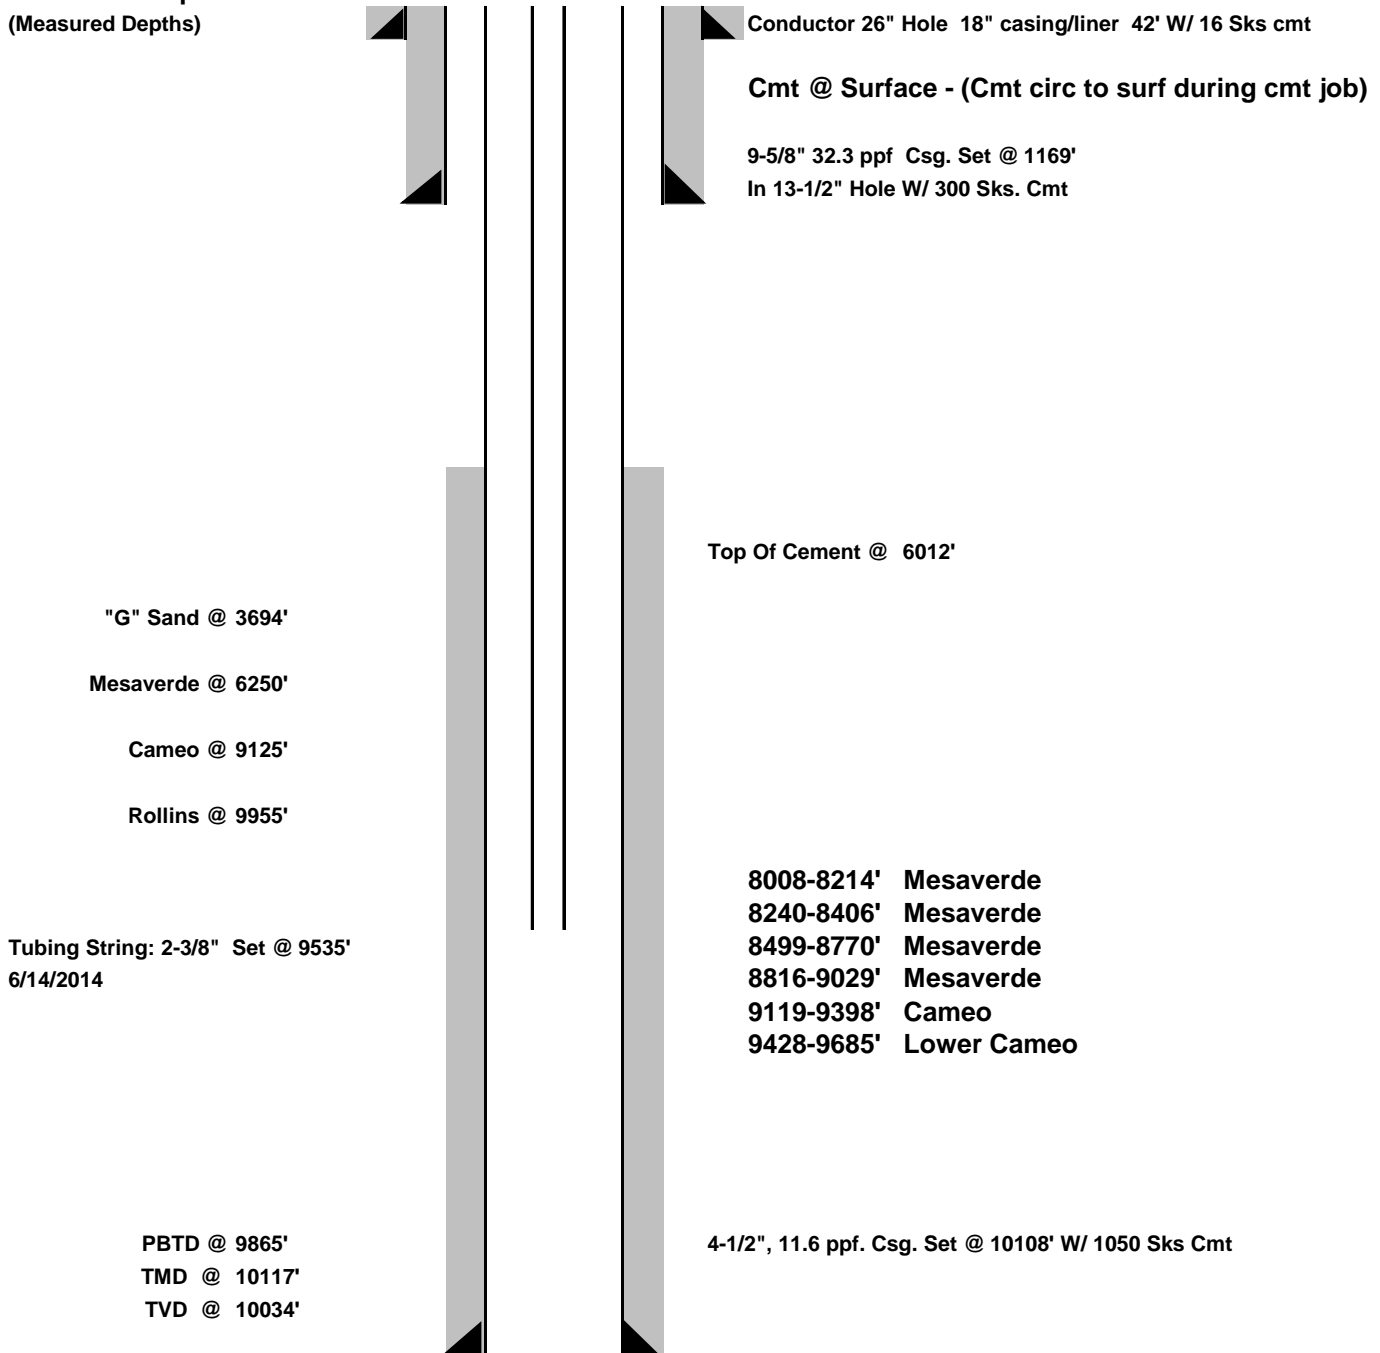

DATE CREATED: 6.30.2014

NOTE: THIS IS NOT TO SCALE.
****FINAL****