

**WPX Energy Rocky Mountain LLC**

**FEDERAL NER 434-32**


**RULISON Field**

**SHL 168' FNL 2598' FWL (SE/4 NW/4) Section 5 T7S R93W 6th PM**

**BHL 359' FSL 1779' FEL (SW/4 SE/4) Section 32 T6S R93W 6th PM**

**Garfield County Colorado**

**Formation Tops**  
(Measured Depths)

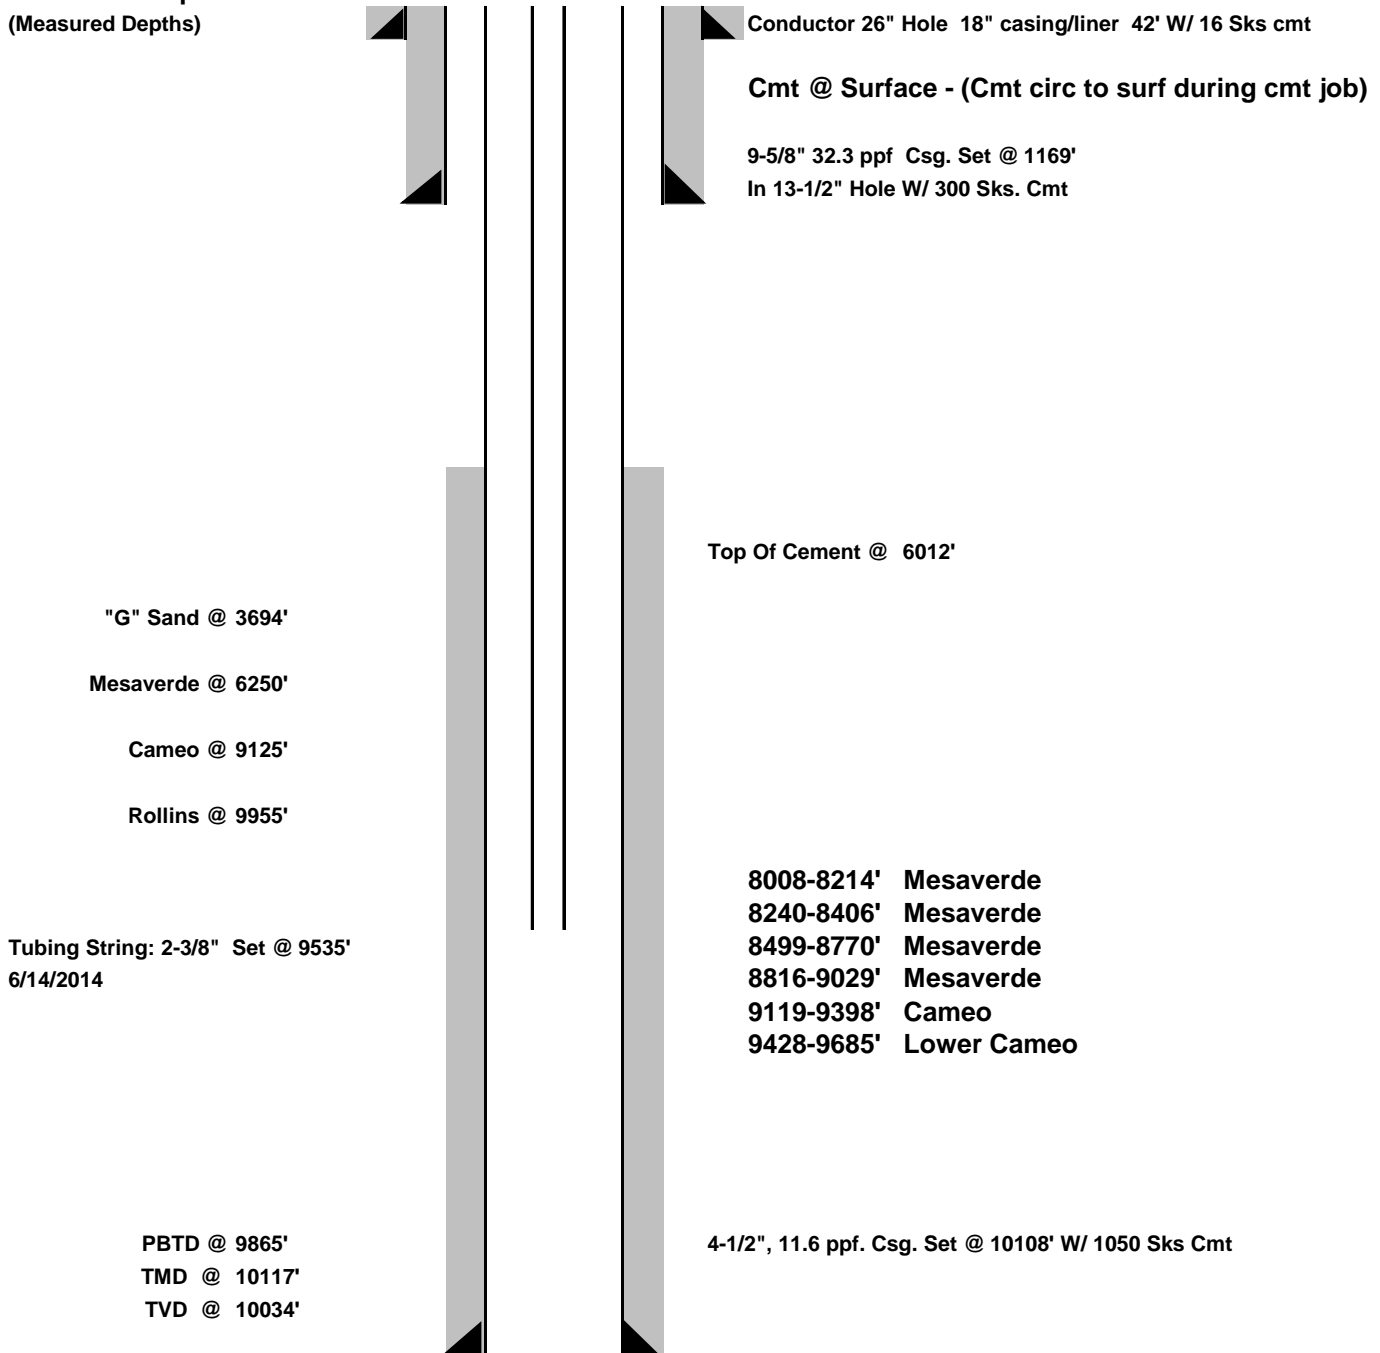

**DATE CREATED: 6.30.2014**

**NOTE: THIS IS NOT TO SCALE.**  
**\*\*FINAL\*\***