

**WPX Energy Rocky Mountain LLC**

**C&C ENERGY GM 422-13**


**GRAND VALLEY Field**

**SHL 266' FSL 1029' FWL (SW/4 SW/4) Section 12 T7S R96W 6th PM**

**BHL 2052' FNL 2152' FWL (SE/4 NW/4) Section 13 T7S R96W 6th PM**

**Garfield County Colorado**

**Formation Tops**  
(Measured Depths)

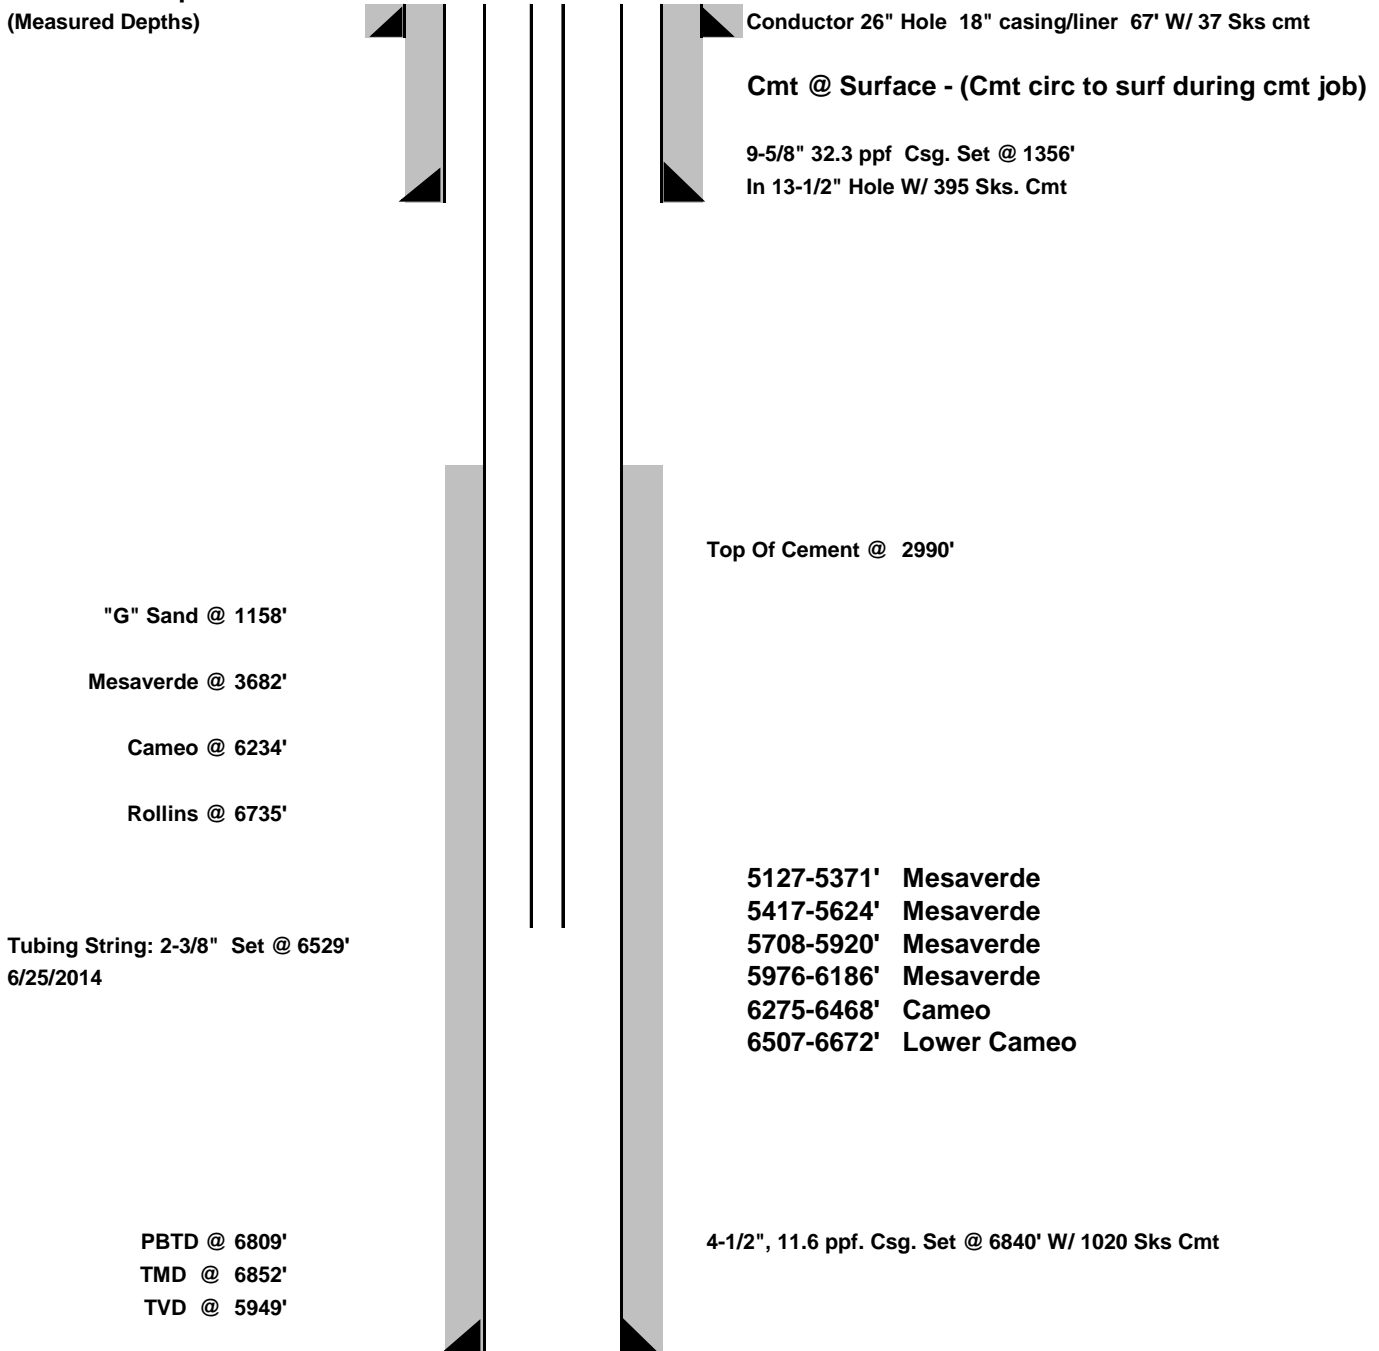

**DATE CREATED: 7.1.2014**

**NOTE: THIS IS NOT TO SCALE.**  
**\*\*FINAL\*\***