

KERR-MCGEE OIL AND GAS ONSHORE LP

HSR-BARCLAY 2-28
NW NE 28 3N 66W -- --
WELD,COLORADO
07/09/2014

AREA: NH

ROUTE: NH3 Spud: 06/26/1994

WINS No.: 73882

AFE/WO#: 2092137

API#: 0512318271

GL: 4963

KB: 4973

MTD: 7578


TVD: 7578

LOG MD: 7570

PBMD: 7509

PBTVD: 7509

Directions: WCR 30 & WCR 31, S 1/2, W 3/10, N 3/10 INTO

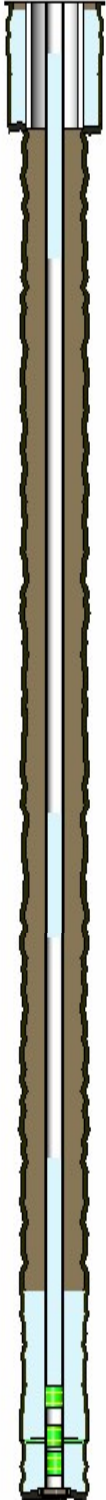

HOLE SECTIONS	Size	Top	Btm	TD Date
SURFACE	12.25	10	655	06/26/1994
PRODUCTION	7.88	655	7578	06/27/1994

TUBULARS	Tool Type	Joints	Size	Weight	Grade	Thread	Top D	Bottom D
SURFACE CASING	Casing	15	8.63	24	S		10	655
PRODUCTION CASING	Casing	227	2.88	6.50			10	7536
	Insert Float						7536	7537
	Casing	1	2.88	6.50			7537	7573
	Casing Guide Shoe						7573	7574
SAND PLUG	Sand Plug	1					7200	7509
BRIDGE PLUG	CIBP With CMT Cap	1	2.88				7110	7121

CEMENT JOBS	Stage	Sacks	Cement Jobs	Top D	Btm D	cbl
SURFACE CASING	STAGE 1	450	NEAT	50	640	No
PRODUCTION CASING	PRIM CMT 1ST STAGE	160	LEAD PREMIUM	6620	7574	Yes
PRODUCTION CASING	ABANDONMENT PLUC	25	LEAD FRESH WATER	5939	7100	No
PRODUCTION CASING	ABANDONMENT PLUC	210	LEAD FRESH WATER	4160	4800	No
PRODUCTION CASING	ABANDONMENT PLUC	360	LEAD FRESH WATER	270	1326	No

PERFORATIONS	Formation	Zone	Top	Btm	Date	Reason	Comments
	CODELL		7419	7428	07/08/1994	PRODUCTION	

Comments: