




Exploration and Production

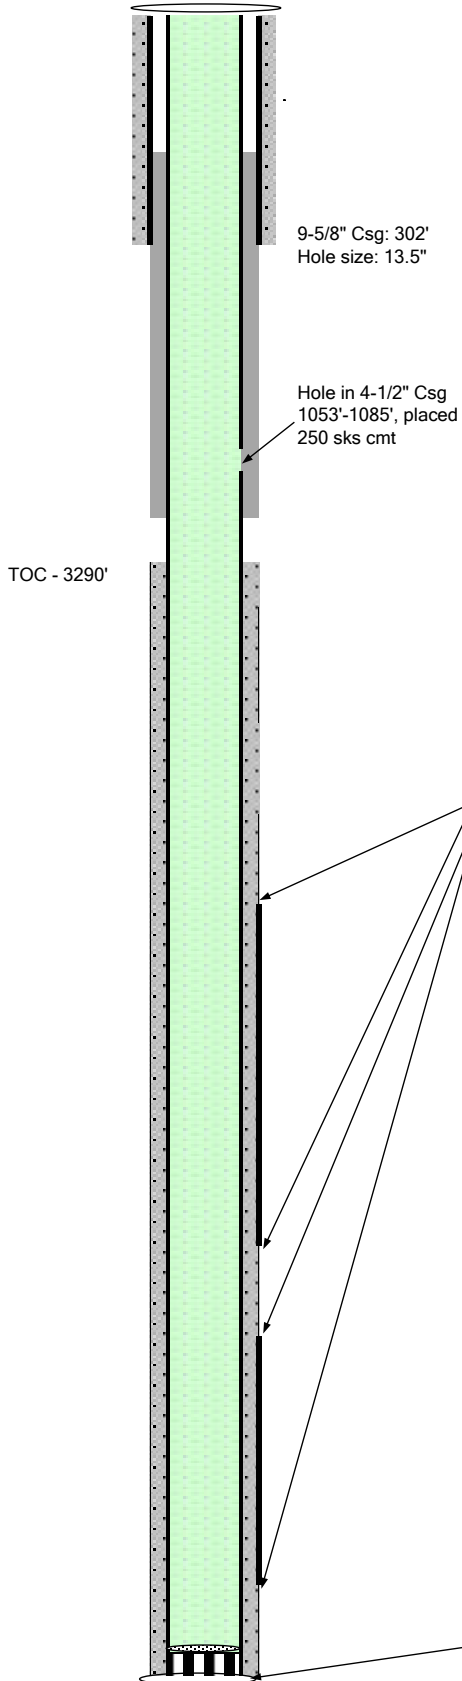

Well Name **GM 259-2**
 Location **NESE 2-7S-96W**
 Field **South Grand Valley**
 County **Garfield, CO**
 API **05-045-07442**
 ELEV **5,229'**
 Footages **1627 FSL 627 FEL**

Spud 11/17/1999

Conductor		
Casing	302'	9-5/8" 36#
Cement	190 sx	Class G
Casing	6299'	4-1/2" 11.6#
Cement	1035 sx	Class G

Tubing **6033'**

Formation Tops

Mesaverde	3219'
Cameo	5766'

TOC - Bond Log **3290'**

Completed Intervals

	<u>Depth</u>	<u># Holes</u>
<u>MV</u>	3818' - 5863'	84
<u>Cameo</u>	5953' - 6160'	12

Cement Squeezes

<u>Depth</u>	<u># Holes</u>	<u>Sks</u>
1053'-1085'	N/A	250