


WELLBORE DIAGRAM
 RETHERFORD NO. 3
 SW NE, SECTION 22, T35N, R20W
 MONTEZUMA COUNTY, COLORADO
 5214' GL 5227.5' KB

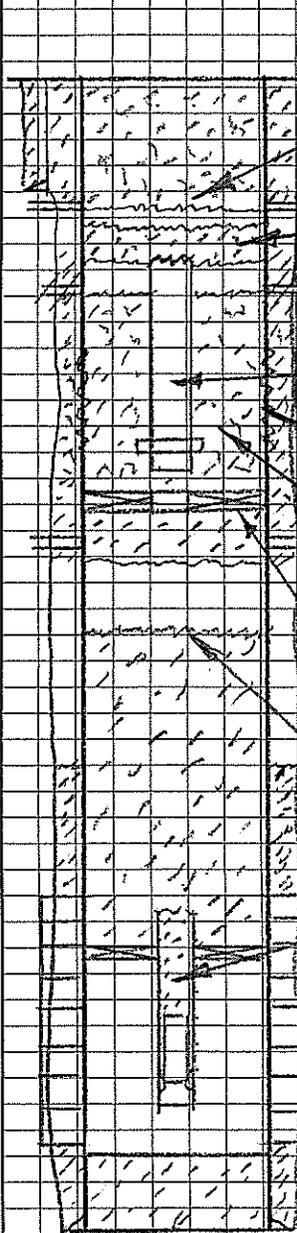

8 5/8" CASING SET AT 240' IN HOLE
 CEMENTED WITH 150 SX. GOOD RETURNS

100 SX CEMENT PLUG INSIDE-OUTSIDE THROUGH PERFS AT 290'
 TO SURFACE.

17 SX CEMENT PLUG 1135 TO 985'

SQUEEZE PERFS 2400'

SQUEEZED 150 SXS BELOW RETAINER AT 2430' INTO BAD CSG.
 CLASS G 1.15 CF/SX. 6/20/12. DRILLED OUT.

2 7/8" TBG 6.5# J55 TOP AT 1200', BOTTOM AT 3005'
 RETAINER SETTING TOOL AND STINGER ON BOTTOM
 OBSTRUCTION IN TUBING AT 1200'

CASING LEAK BAD PIPE 2478-2920'
 TIGHT SPOT PROBABLY METAL AT 2780'; 8"

UNKNOWN CEMENT AND FILL ON TOP OF RETAINER

SQUEEZED 150 SXS BELOW RETAINER AT 3007' INTO PERFS
 AT 3100' GOOD CIRC AROUND RETAINER MOST OF JOB
 STING OUT OF RETAINER . PIPE STUCK, CLASS G 1.15 CF/SX. 6/27/12

CEMENT RETAINER AT 3007'
 SQUEEZE PERFS 3100'

FILL IN CASING FROM DE CHELLY LEAK TO ABOUT 3500'

2 7/8" TBG 6.5# J55 (NO TALLY)	TOP AT	5,690.00
TUBING ANCHOR		
PUMP 2 1/2" X 1.5" X 16' RWBC	(SEATED IN SEATING NIPPLE)	
2 7/8" SEATING NIPPLE AND MA	11'	AT 5835'
FILL INSIDE TUBING AT 5793'		

PERFS 5678-86, 5690-5700, 5720-26, 5740-56, 5785-91,
 5806-28' 1 SPF.ACIDIZED 17500 GAL RETARDED & 40000 GAL
 REGULAR

5 1/2" 15.5# J-55 CASING SET AT 5923'. CEMENTED WITH 120
 SX 50:50 POZ, 2% GEL, 70 SX LATEX

7 7/8" HOLE

PBB:	5886
TD:	5925