



**Wellbore Schematic**

Well Name: GOVERNMENT POHLMAN 1  
 S.H.Location: NW1/4 15-4N-91W 225FNL 260FWL  
 B.H. Location: NW1/4 15-4N-91W 225FNL 260FWL  
 County: MOFFAT COUNTY, CO  
 API #: 05-081-05169  
 Co-ordinates: 40.326579 N LAT, 107.600422 W LON  
 Elevations: GROUND: 6981'  
                   KB: 3'  
 Depths (KB): PBD: 3140'  
                   TD: 3140'

Date Prepared: 7/16/2014  
 Last Updated: 6/19/2014  
 Spud Date: 9/11/1926  
 Completion Date: 2/12/1927  
 Last Workover Date: 6/16/2014

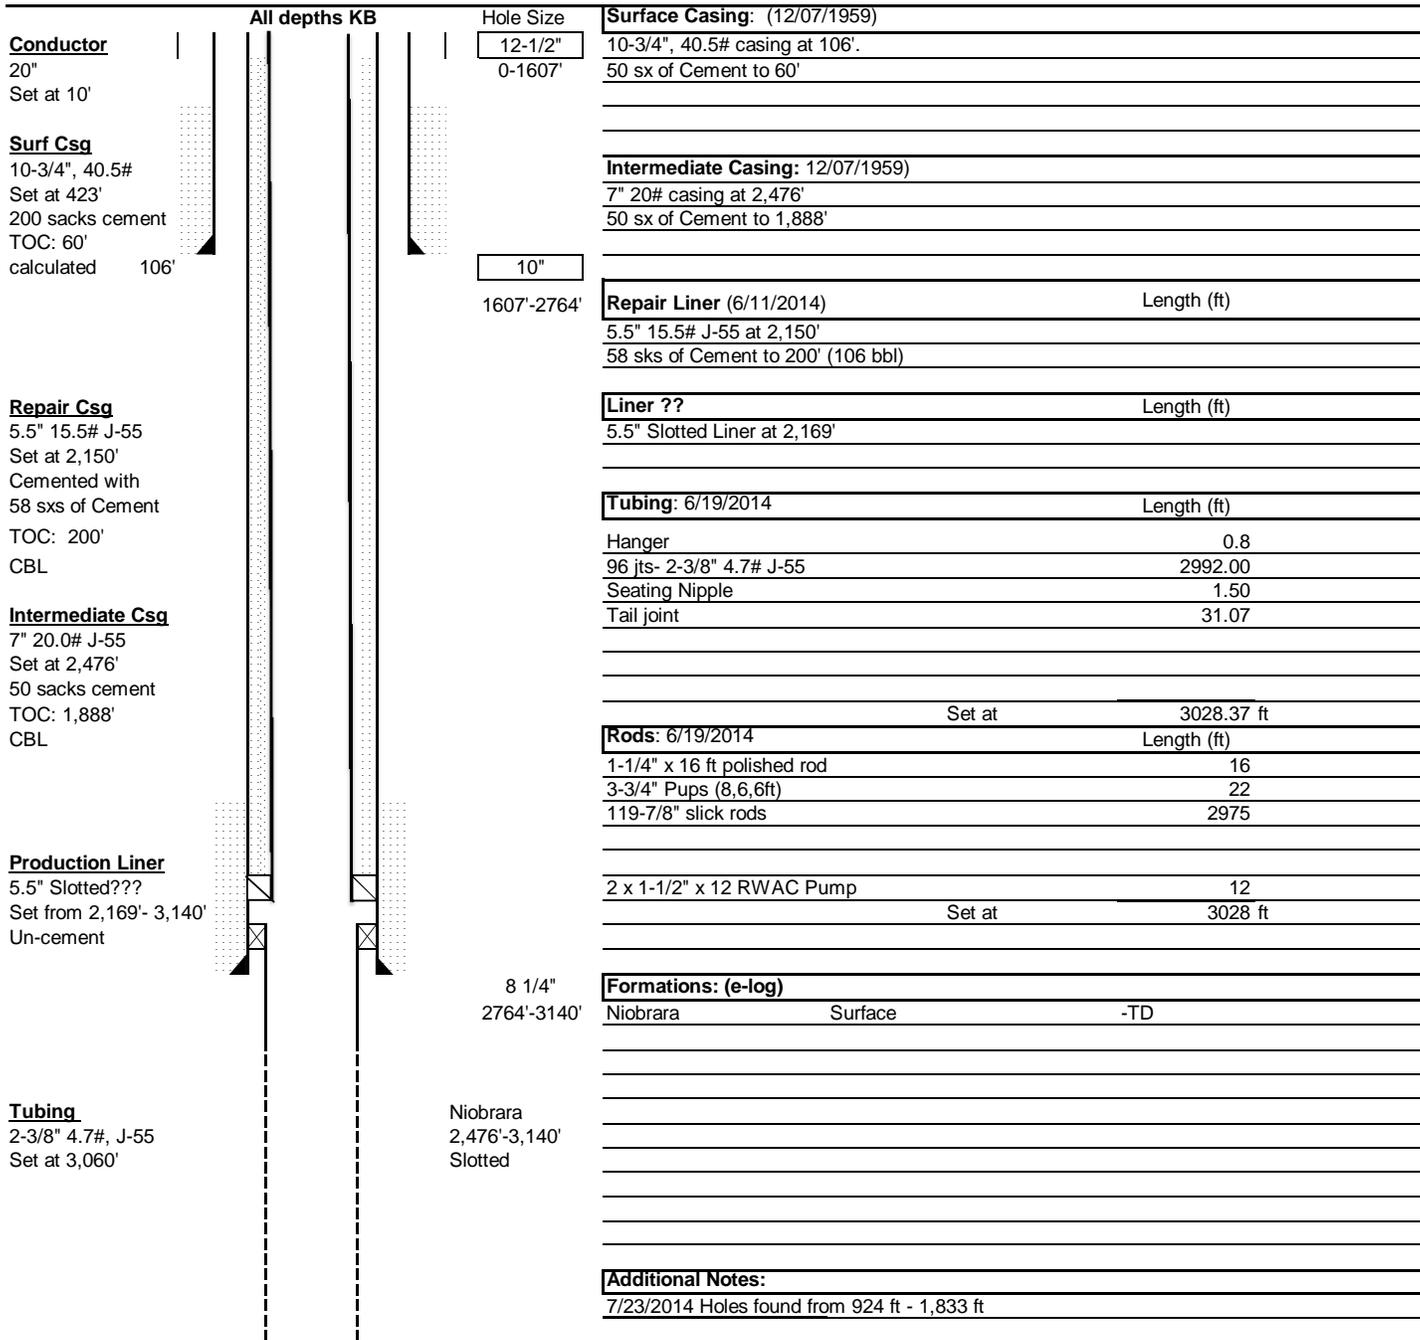

Site Facility Diagram

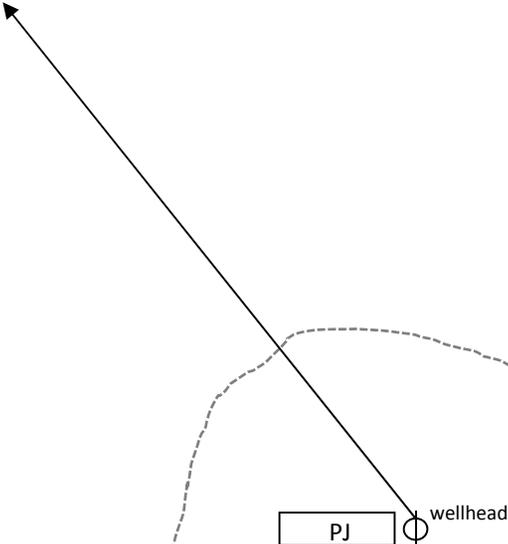

**REMARKS:**

Map not to scale.

Updated 8/8/2011 - HT

This lease is subject to the site security plan for Robert L. Bayless, Producer LLC. The plan is located at:  
**Robert L. Bayless, Producer LLC**  
**PO Box 168**  
**368 NM Highway 170**  
**Farmington, NM 87499**

**Robert L. Bayless, Producer LLC**  
**GOV'T POHLMAN #1**  
225' FNL & 260' FWL  
Section 15, T4N, R91W  
Moffat County, CO  
Lease No. COD033221B

ROBERT L BAYLESS, PRODUCER LLC  
PO Box 168  
Farmington, New Mexico 87499  
505-326-2659  
505-326-6911 fax

**Workover Summary Log**

**12/7/1959**

Well Re-entered. Plugs Drilled and Casing run cemented as Niobrara

**10/4/2007**

Strip well and change pump

**7/1/2009**

Strip well and change pump

**12/12/2013**

Test casing and find holes in 7 inch. Run 4.5" liner to repair holes and test.

**6/19/2014**

Cement 5.5" Casing and repair holes. Return to production.