

**KERR-MCGEE OIL AND GAS ONSHORE LP**

**BELL L 12-15**

**SW SE 12 3N 66W 560' FSL 2,169' FWL**

**WELD,COLORADO**

**07/17/2014**

**AREA: N1**

**ROUTE: N11**

**Spud: 06/03/1992**

**WINS No.: H5061**

**AFE/WO#: 2098363**

**API#: 0512315717**

**GL: 5003**

**KB: 5013**

**MTD: 7609**

**TVD: 7609**


**LOG MD: 7598**

**PBMD: 7607**

**PBTVD: 7607**

**Directions:**

**CR 34 & CR 35, E 8/10, N 1/10, W INTO. ON LOC: BRATTAIN 12-15D. KEEP GATE CLOSED**

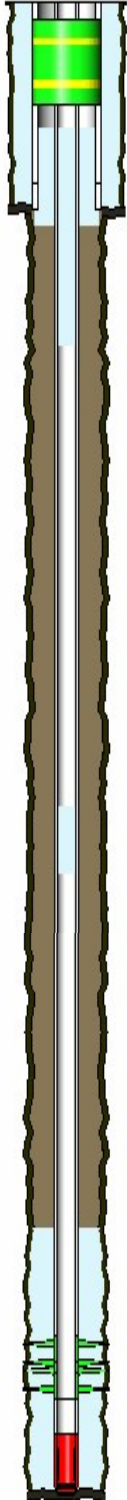

<u>HOLE SECTIONS</u>	<u>Size</u>	<u>Top</u>	<u>Btm</u>	<u>TD Date</u>				
SURFACE	12.25	10	570	06/03/1992				
PRODUCTION	7.88	570	7610	06/08/1992				
<u>TUBULARS</u>	<u>Tool Type</u>	<u>Joints</u>	<u>Size</u>	<u>Weight</u>	<u>Grade</u>	<u>Thread</u>	<u>Top D</u>	<u>Bottom D</u>
SURFACE CASING	Casing	13	8.62	24.00	J-55		10	560
	Casing	1	8.62				560	561
PRODUCTION CASING	Casing	235	2.88	8.70	N-80		10	7410
	Casing	6	2.88	6.50	C-75		7410	7607
	Casing Float Shoe	1	2.88				7607	7609
BRIDGE PLUG	Cast Iron Bridge Plu	1	8.63				80	82
<u>CEMENT JOBS</u>	<u>Stage</u>	<u>Sacks</u>	<u>Cement Jobs</u>		<u>Top D</u>	<u>Btm D</u>	<u>cbl</u>	
SURFACE CASING	SURFACE CASING CE	290	Lead		10	561	No	
PRODUCTION CASING	PRODUCTION CASINC	220	Lead		6736	7609	Yes	
PRODUCTION CASING	ABANDONMENT PLUC	300	LEAD	CEMENT	4186	4596	No	
PRODUCTION CASING	ABANDONMENT PLUC	630	LEAD	FRESH WATER	671	1386	No	
--None--	ABANDONMENT PLUC	135	LEAD	FRESH WATER	215	664	No	
<u>PERFORATIONS</u>								
<u>Formation</u>	<u>Zone</u>	<u>Top</u>	<u>Btm</u>	<u>Date</u>	<u>Reason</u>	<u>Comments</u>		
CODELL		7392	7434	06/18/1992	PRODUCTION			
CODELL		7422	7438	07/01/2000	PRODUCTION			

**Comments:**