


KERR-MCGEE OIL AND GAS ONSHORE LP
GILBERT ACORD GAS UNIT 1
SE SW 29 3N 67W 990' FSL 1,650' FWL
WELD,COLORADO
07/21/2014

AREA: W2 ROUTE: W24 Spud: 06/23/1975 WINS No.: 74647 AFE/WO#: 2098362 API#: 0512308413

GL: 4791 KB: 4801 MTD: 7760 TVD: 7760 LOG MD: PBMD: 7716 PBTVD: 7716

Directions: CR 17 & CR 26 3/4, W 2/10, NW THROUGH FARM YARD 2/10, W INTO. INTO. SLOW THROUGH YARD

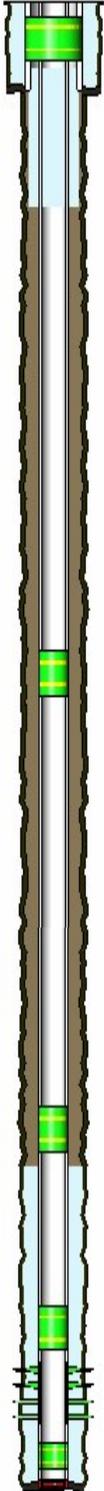

<u>HOLE SECTIONS</u>	<u>Size</u>	<u>Top</u>	<u>Btm</u>	<u>TD Date</u>				
SURFACE	12.25	10	271	06/23/1975				
PRODUCTION	7.88	271	7793	07/01/1975				
<u>TUBULARS</u>	<u>Tool Type</u>	<u>Joints</u>	<u>Size</u>	<u>Weight</u>	<u>Grade</u>	<u>Thread</u>	<u>Top D</u>	<u>Bottom D</u>
SURFACE CASING	Casing	7	8.63	23.00			10	271
PRODUCTION CASING	Casing	190	4.50	11.60	K-55	LTC	10	7750
		1	4.50				7750	7751
	Casing	1	4.50	11.60	K-55	LTC	7751	7792
	Casing Guide Shoe	1	4.50				7792	7793
BRIDGE PLUG	CIBP With CMT Cap	1	4.50				7580	7582
CAST IRON CEMENT RETAINER	Cement Retainer	1	4.50				6580	6582
CAST IRON CEMENT RETAINER	Cement Retainer	1	4.50				3910	3912
BRIDGE PLUG	Cast Iron Bridge Plu	1	8.63				80	83
<u>CEMENT JOBS</u>	<u>Stage</u>	<u>Sacks</u>	<u>Cement Jobs</u>		<u>Top D</u>	<u>Btm D</u>	<u>cbl</u>	
SURFACE CASING	PRIM CMT 1ST STAGE	250	LEAD	CEMENT	10	271	No	
	PRODUCTION CASING	PRIM CMT 1ST STAGE	200	LEAD	CEMENT	6669	7793	No
CAST IRON CEMENT RETAINER	ABANDONMENT PLUC	130	LEAD	FRESH WATER	6400	6910	No	
CAST IRON CEMENT RETAINER	ABANDONMENT PLUC	450	LEAD	FRESH WATER	3700	4480	No	
SURFACE CASING	ABANDONMENT PLUC	550	LEAD	FRESH WATER	130	1030	No	
<u>PERFORATIONS</u>	<u>Formation</u>	<u>Zone</u>	<u>Top</u>	<u>Btm</u>	<u>Date</u>	<u>Reason</u>	<u>Comments</u>	
			3880	3881	07/03/2014	CEMENT SQUEEZE		
			4480	4481	07/03/2014	CEMENT SQUEEZE		
			6540	6541	07/02/2014	CEMENT SQUEEZE		
			6910	6911	07/02/2014	CEMENT SQUEEZE		
	J SAND		7643	7646	08/26/1975	PRODUCTION		
	J SAND		7653	7682	08/26/1975	PRODUCTION		

Comments: