

# Kammerzell #7-4

Latitude/Longitude: N40.32862000, W -104.81476000:


Township/Range: 7 004-N

Sene -Sec. 7 -T4N-R66W, 6Th Pm

County: Weld, State: CO

Spud Date: 2/18/2005

Total Depth: 7347

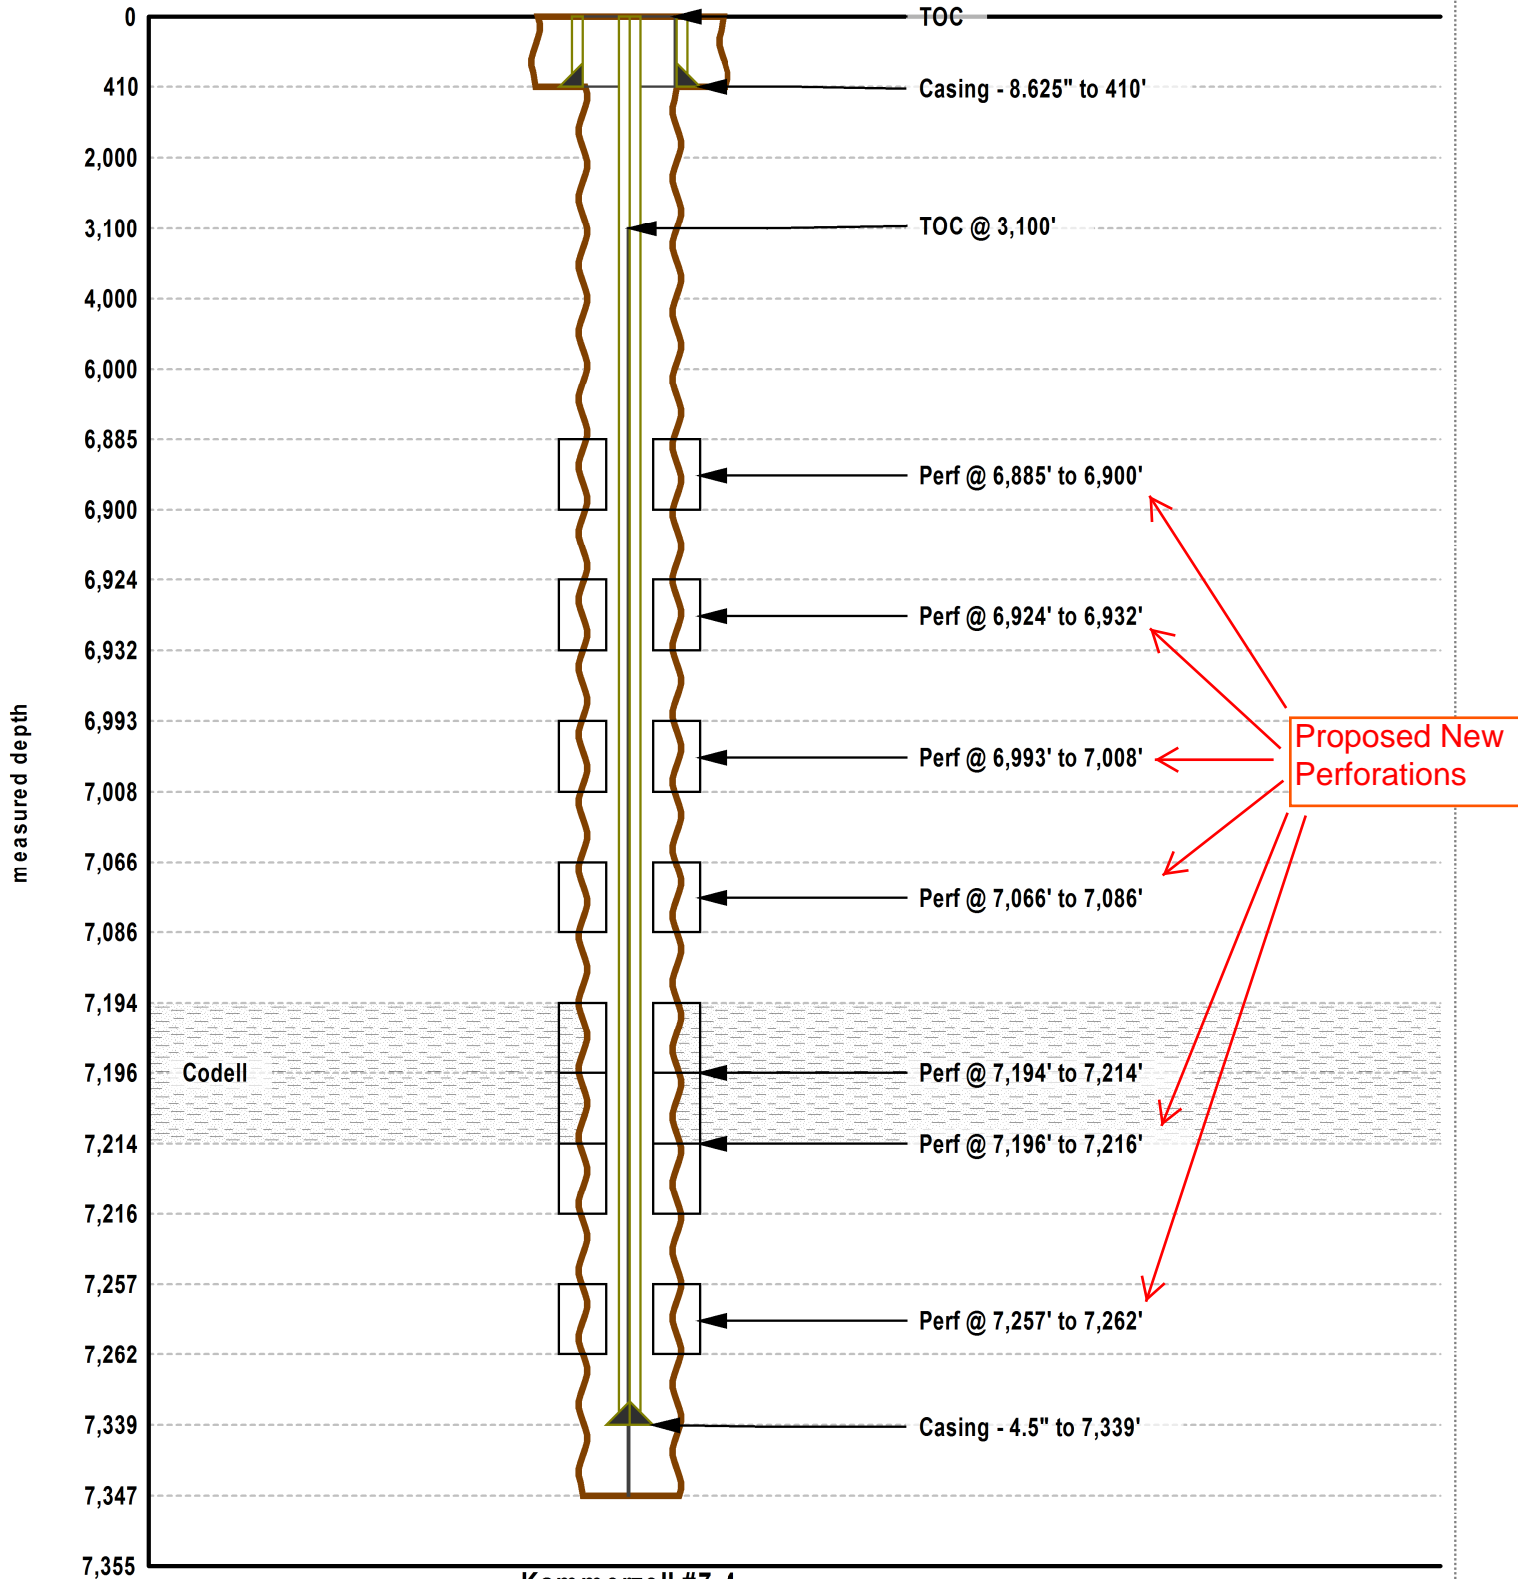

Kammerzell #7-4

Initial Completion: 3/16/2005

Proposed Depth: 7300 Plug Back Depth: 7325