

## Phelps #1-13

Latitude/Longitude: N40.30626200, W -104.81330100:


Township/Range: 18 004-N

Sese, Sec. 18, T4N-R66W, Weld Co., Co

County: Weld, State: CO

Spud Date: 12/28/1983

Total Depth: 7350

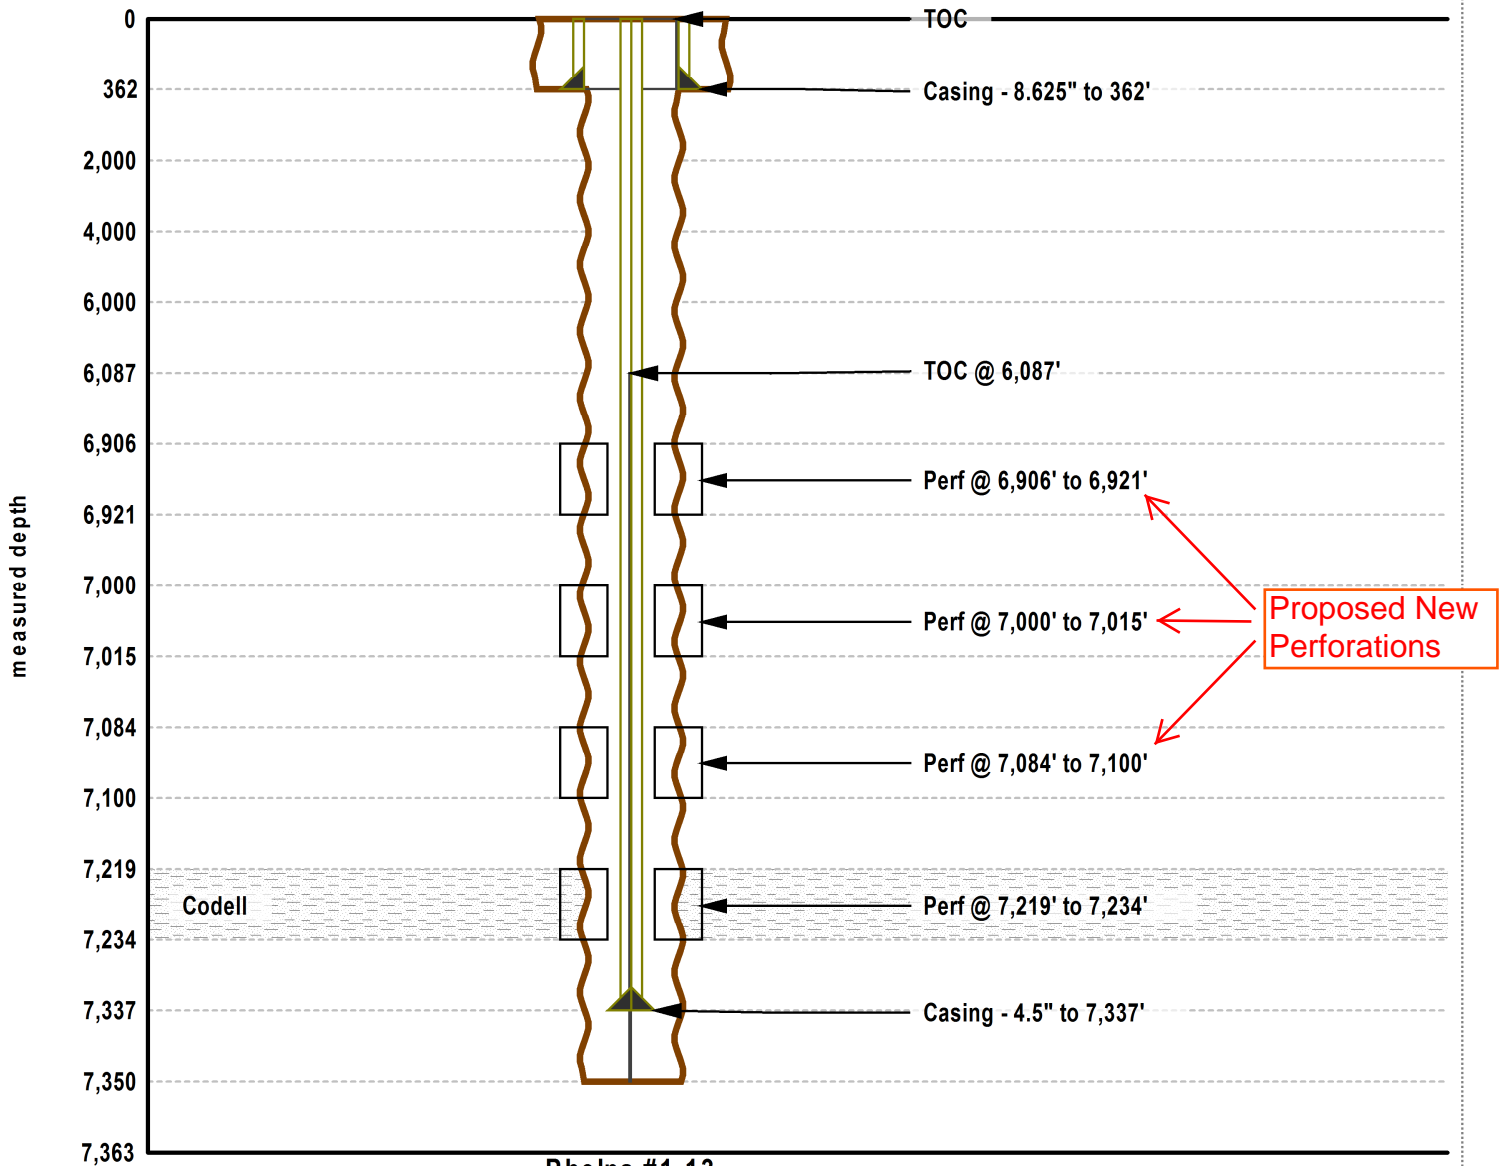

Phelps #1-13

Initial Completion: 1/23/1984

Proposed Depth: 0 Plug Back Depth: 7317