

KERR-MCGEE OIL AND GAS ONSHORE LP

PLATTE 23-2

SE SW 2 3N 67W 710' FSL 2,155' FWL

WELD,COLORADO

08/01/2014

AREA: N2

ROUTE: N28 Spud: 05/04/2008

WINS No.: 93259

AFE/WO#: 88549768

API#: 0512325712

GL: 4763

KB: 4777

MTD: 7425


TVD: 7336

LOG MD: 7427

PBMD: 7392

PBTVD: 7302

Directions: WCR 23 & WCR 38, W 1/4, S 3/4, W 1/4

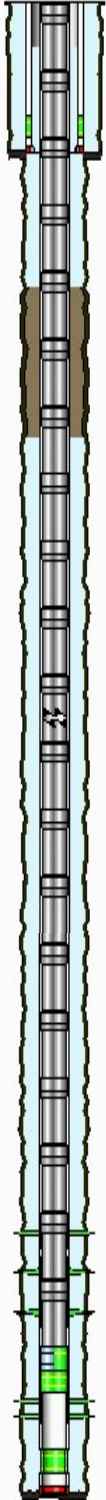

<u>HOLE SECTIONS</u>	<u>Size</u>	<u>Top</u>	<u>Btm</u>	<u>TD Date</u>					
SURFACE	12.25	14	736	05/04/2008					
PRODUCTION	7.88	736	7425	05/08/2008					
<u>TUBULARS</u>	<u>Tool Type</u>	<u>Joints</u>	<u>Size</u>	<u>Weight</u>	<u>Grade</u>	<u>Thread</u>	<u>Top D</u>	<u>Bottom D</u>	
SURFACE CASING	Casing	15	8.63	24.00	J-55	LT&C	14	681	
	Baffle	1	8.63				681	681	
	Casing	1	8.63	24.00	J-55	LT&C	681	725	
	Casing Guide Shoe	1	8.63				725	727	
PRODUCTION CASING	Casing	168	4.50	11.60	I-80	LTC	14	7392	
	Latch Down Baffle	1	4.00				7392	7392	
	Casing	1	4.50	11.60	I-80	LTC	7392	7408	
	Casing Float Shoe	1	4.50		P-110		7408	7410	
PRODUCTION TUBING	Tubing	229	2.38	4.70	J-55	External-Ups	14	7257	
	XN Profile Nipple	1					7257	7258	
	Notched Collar	1					7258	7259	
<u>CEMENT JOBS</u>	<u>Stage</u>	<u>Sacks</u>	<u>Cement Jobs</u>				<u>Top D</u>	<u>Btm D</u>	<u>cbl</u>
SURFACE CASING	PRIM CMT 1ST STAGE	500	LEAD	TYPE 3			14	730	No
PRODUCTION CASING	PRIM CMT 1ST STAGE	500	LEAD	Haliburton Light standard			3900	6554	Yes
	PRIM CMT 1ST STAGE	150	TAIL	FracCem.			6554	7415	Yes
PRODUCTION CASING	ONE INCH JOB	180	LEAD	FRESH WATER			268	1505	Yes
<u>PERFORATIONS</u>									
<u>Formation</u>	<u>Zone</u>	<u>Top</u>	<u>Btm</u>	<u>Date</u>	<u>Reason</u>	<u>Comments</u>			
NIOBRARA	A	6980	6990	06/10/2008	PRODUCTION				
NIOBRARA	B	7046	7056	06/10/2008	PRODUCTION				
NIOBRARA	C	7124	7144	06/10/2008	PRODUCTION				
CODELL		7266	7284	06/06/2008	PRODUCTION				

Comments: