

**WPX Energy Rocky Mountain LLC**

**C&C ENERGY GM 22-13**


**GRAND VALLEY Field**

**SHL 271' FSL 1015' FWL (SW/4 SW/4) Section 12 T7S R96W 6th PM**

**BHL 1327' FNL 2174' FWL (SE/4 NW/4) Section 13 T7S R9WW 6th PM**

**Garfield County Colorado**

**Formation Tops**  
(Measured Depths)

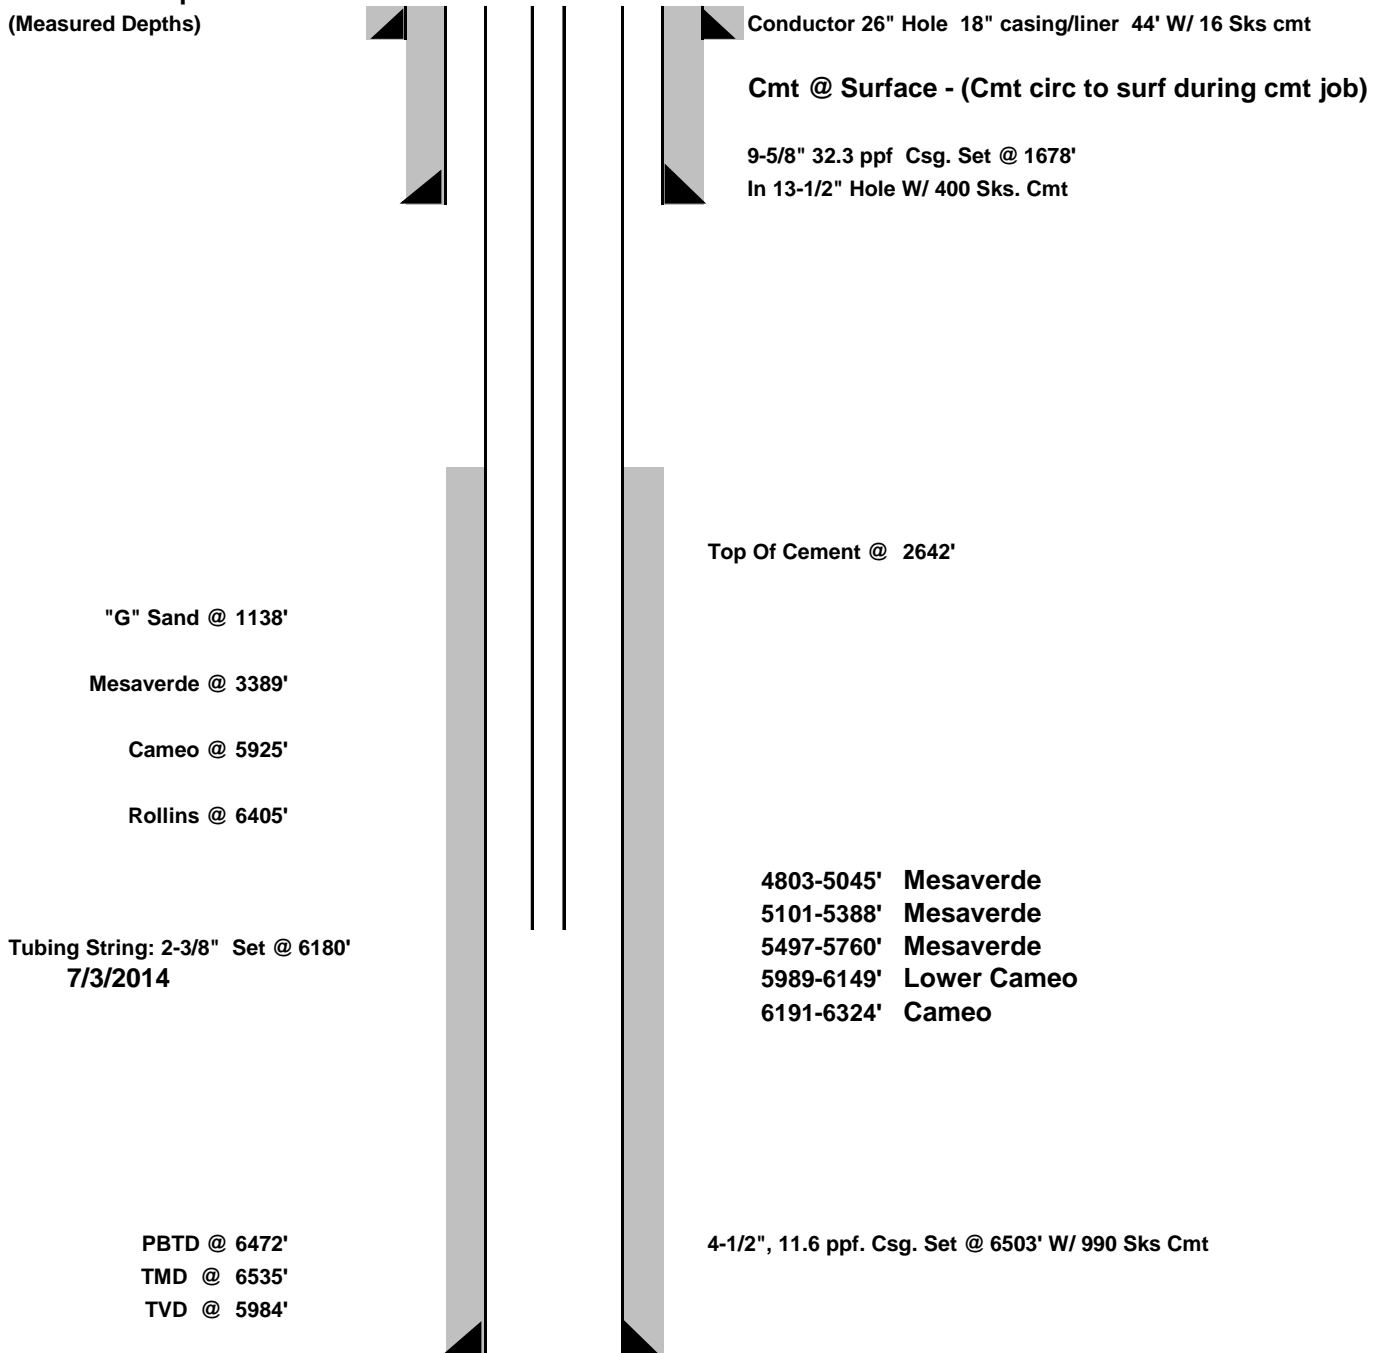

**DATE CREATED: 7.10.14**

**NOTE: THIS IS NOT TO SCALE.**  
**\*\*FINAL\*\***