Physical Address: 345 Comanche St.
Mail to: Box 384, Kiowa, CO 80117
Ph. 303-621-8672 - Fax 303-621-7749
www.highprairiesurvey.com

Well Location Certificate: BOYD FARMS #33-28

High Prairie Surveying of Kiowa, Colorado in accordance with a request from **Duncan Oil, Inc**., has determined the location of **BOYD FARMS #33-28** to be **1980 feet FSL**, and **1880 feet FEL**, (90° off Section lines) of SECTION **28**, Township **6s**, Range **54w** of the 6th Principal Meridian, **Lincoln County**, Colorado.

Date: Staked on 07/14/14 drawn on 07/25/14.

Re: Staked by Elijah Frane
Drawn: Drawn by Dustin Cotter

Basis of Elevation Spot: USGS BM = TETLOW, PID = KJ0482, H-Order = Adjusted, V-Order = Scaled, Stability = Unknown, P-DOP = 2.6, Sats = 7 US NAD 83 CO-C 502, Lat. = 39.55762, Long. = W103.43345, Elevation = 5256.00 gr. (us FT).

Notes: See Location Drawing for improvements within 500 feet of the proposed well pad.
The ground elevation at staked location = 5285.01' gr.
This drawing does not represent a monumented survey or Land Survey Plat.
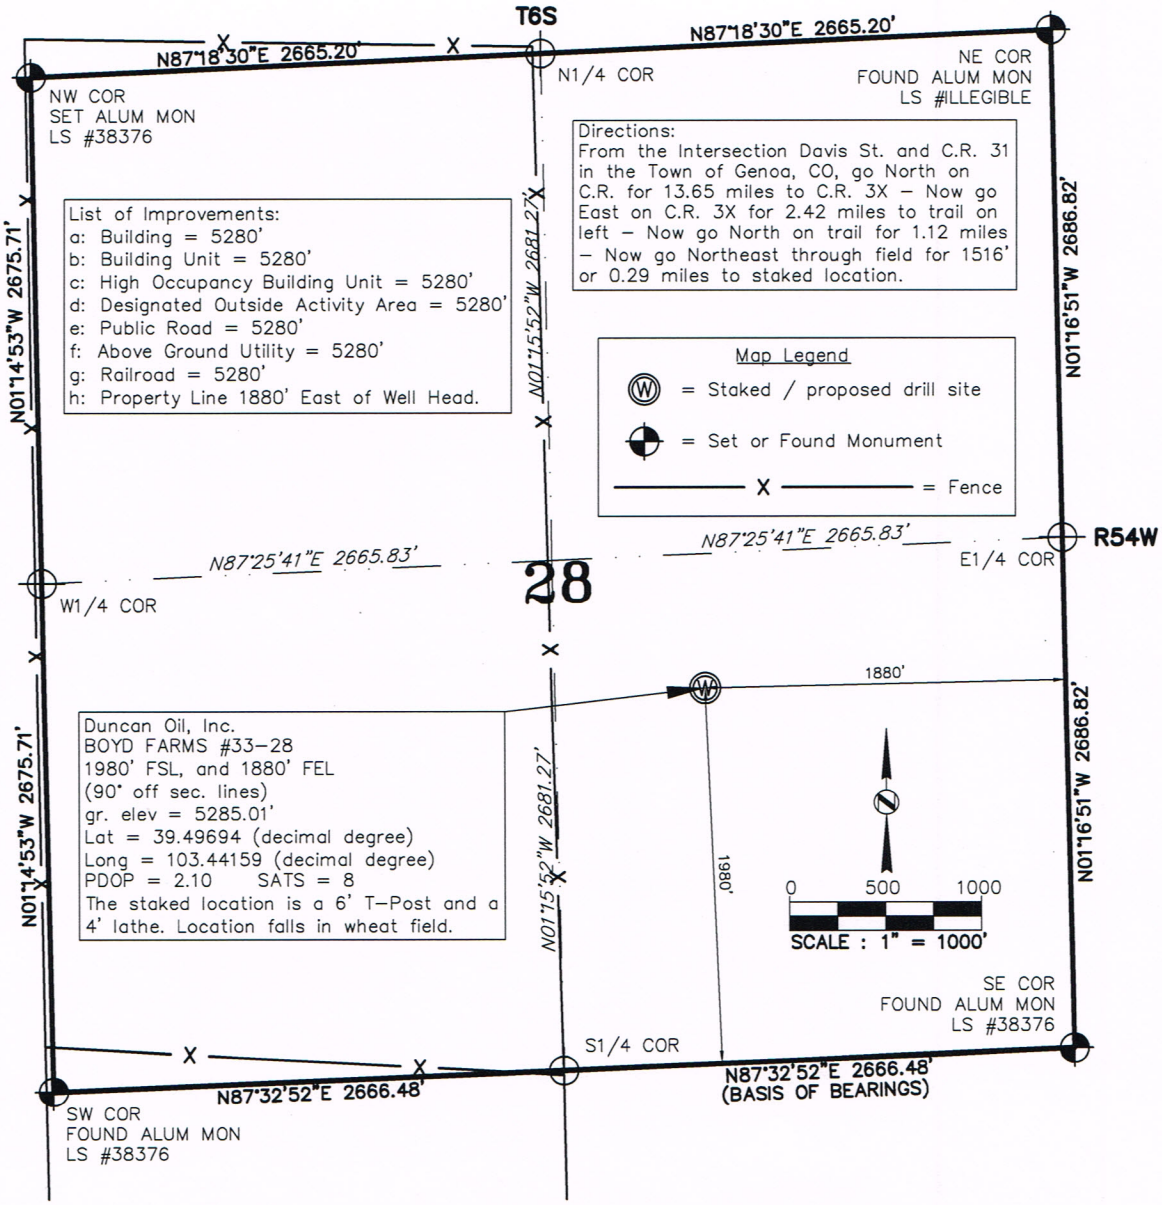
Basis of Bearings: Bearings were determined based on the South line of Section 28 to bear N87°32'52"E with all other bearings contained herein relative thereto.